


NY PLACERING
2023-05-17

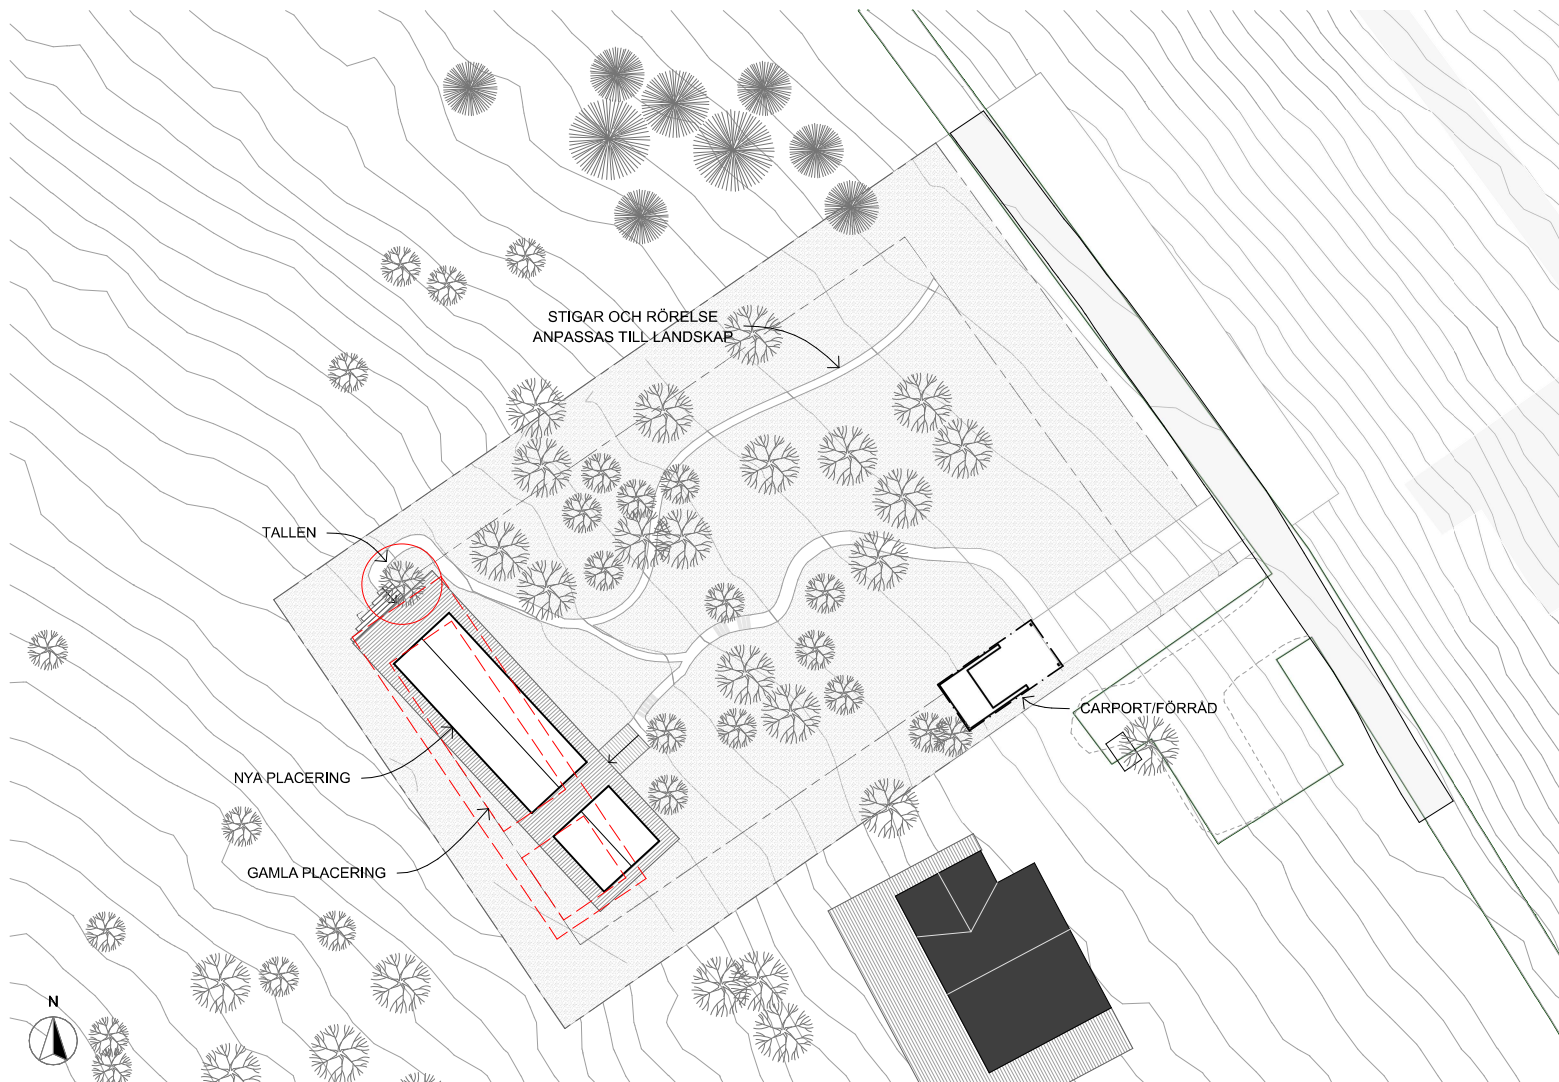

SITUATIONSPLAN
1:400

