


RÖDINGEN 2, MÖLNDAL
FASADRIDNING NR. 1
MÖLNDAL 2022-02-15
SKALA 1:100


MOT ÖSTER



39 X

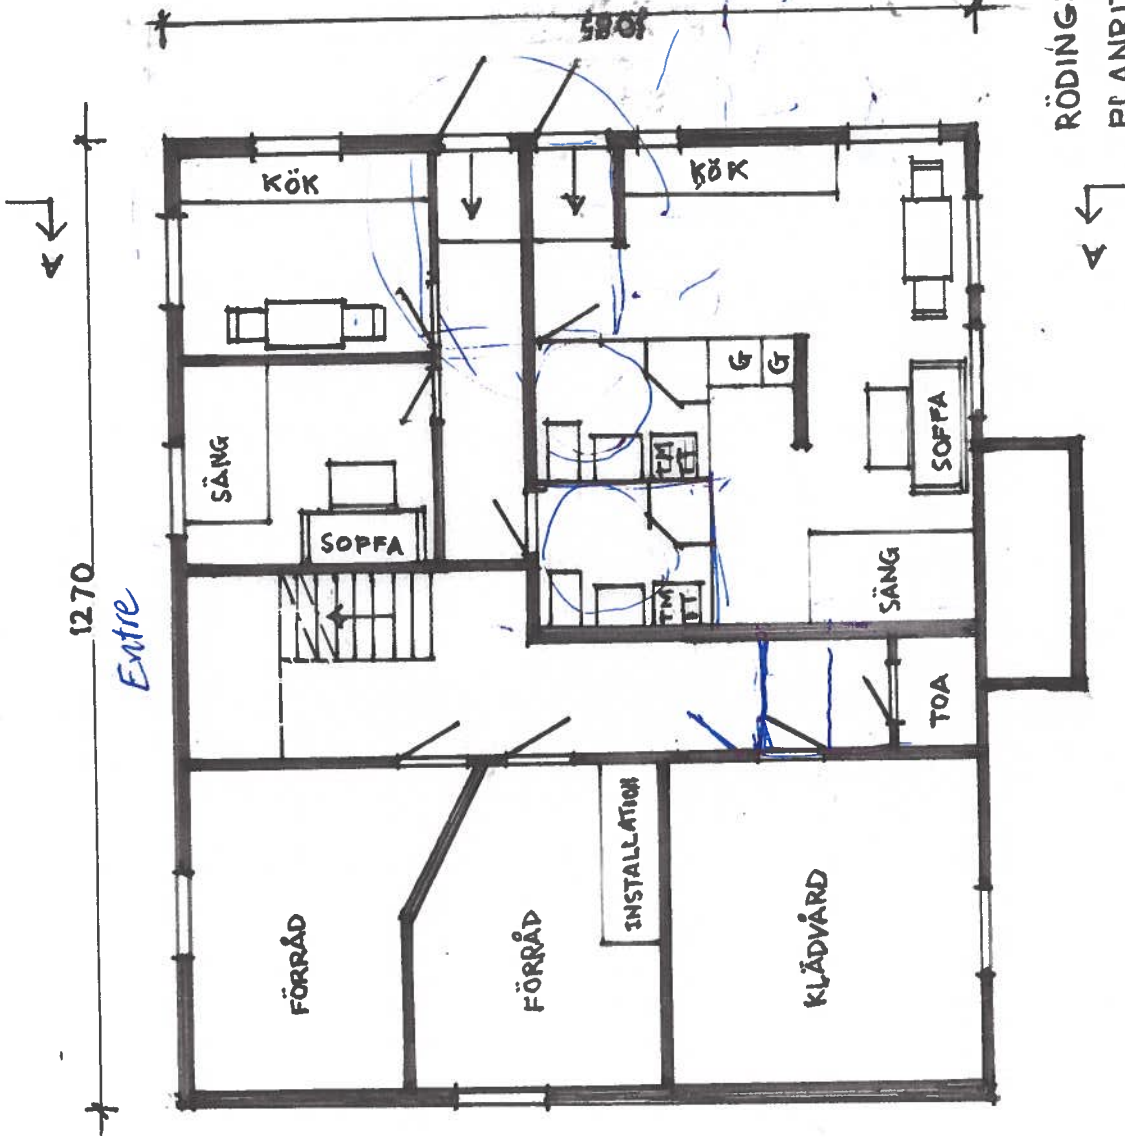

RÖDINGE9. MÖLNDAL
 PLANRITNING NR. 6
 SKALA 1:100
 MÖLNDAL 2022-02-15

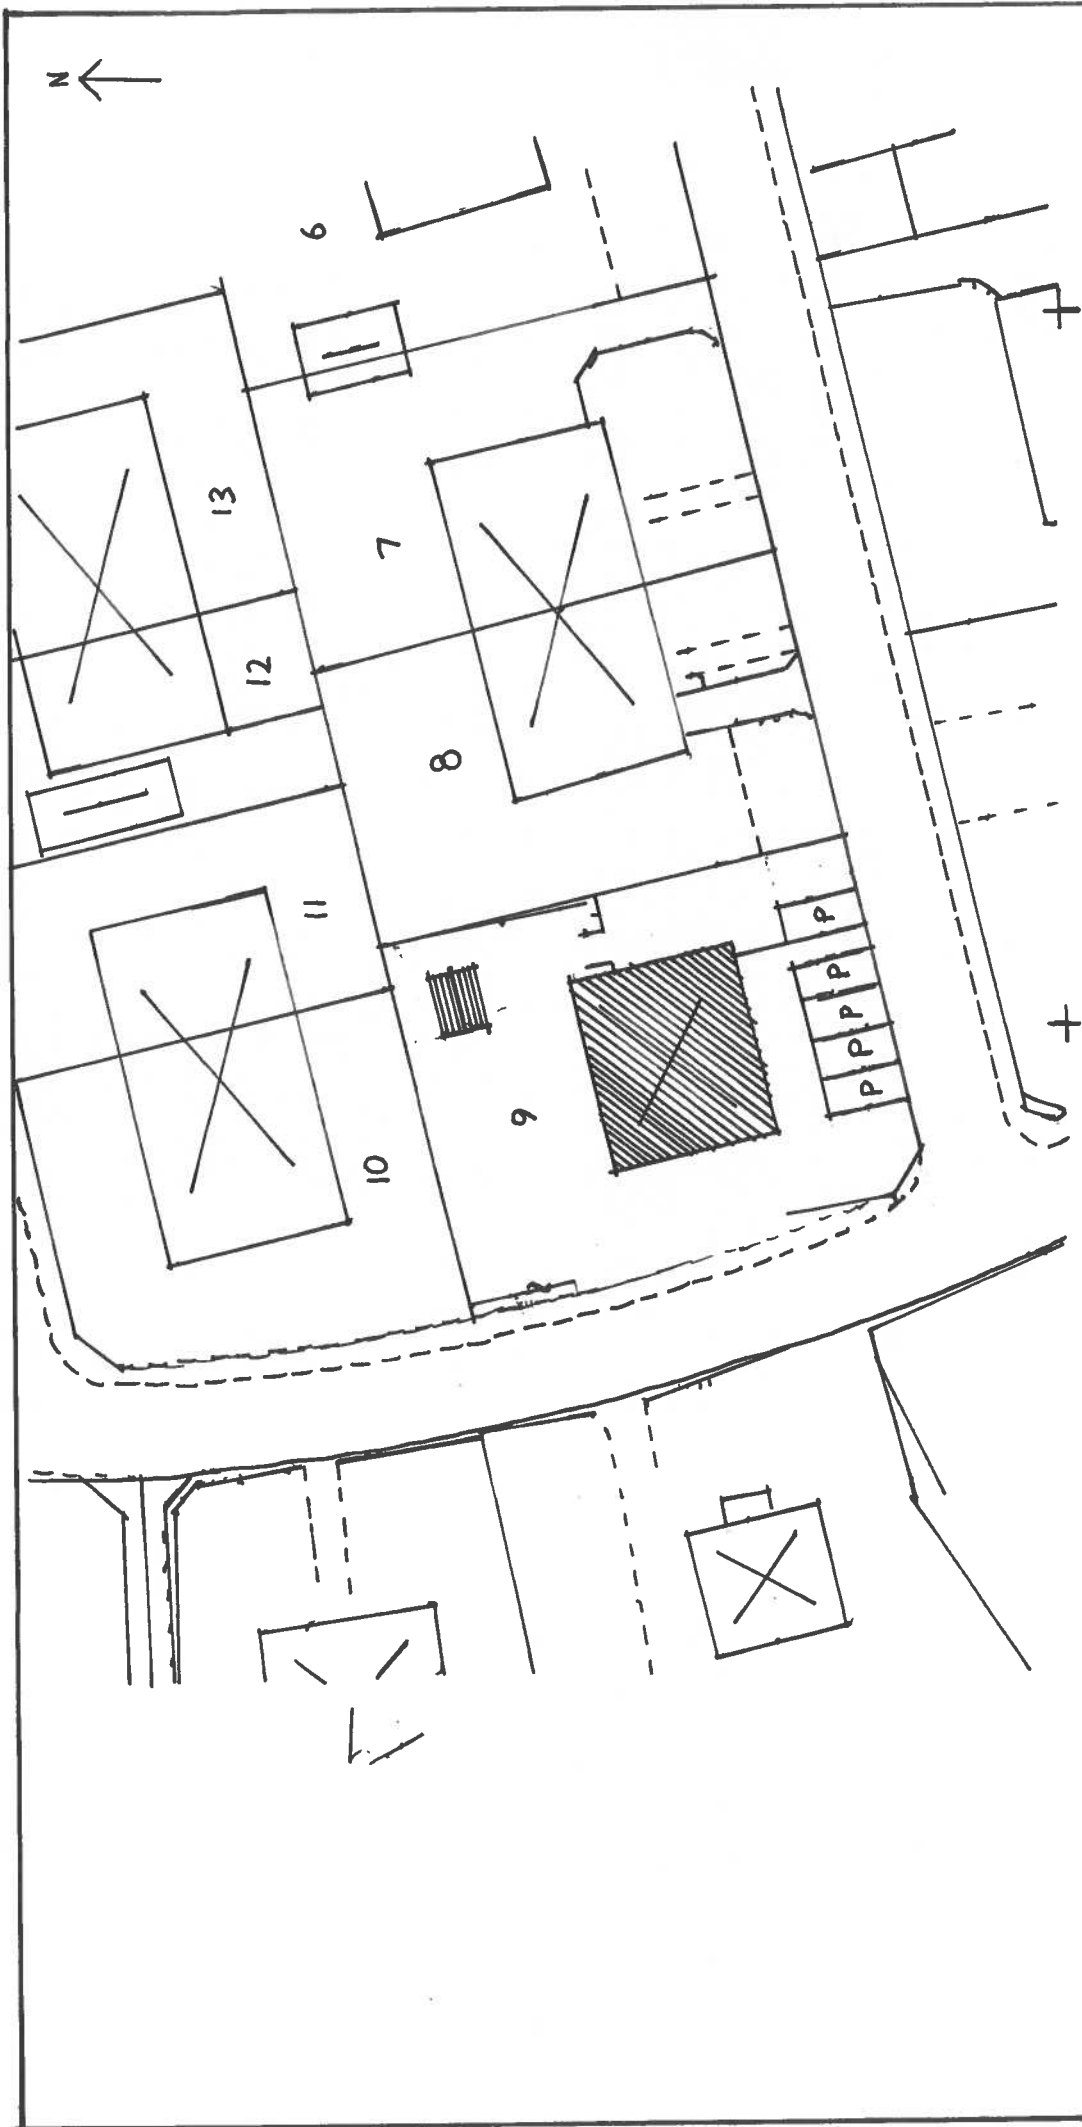

RÖDINGEN 9, MÖLNDAL
SITUATIONSPLAN NR.5
MÖLNDAL 2022-02-15
SKALA 1:500