




Slänge 2:1 Tanums kommun

december 12, 2016

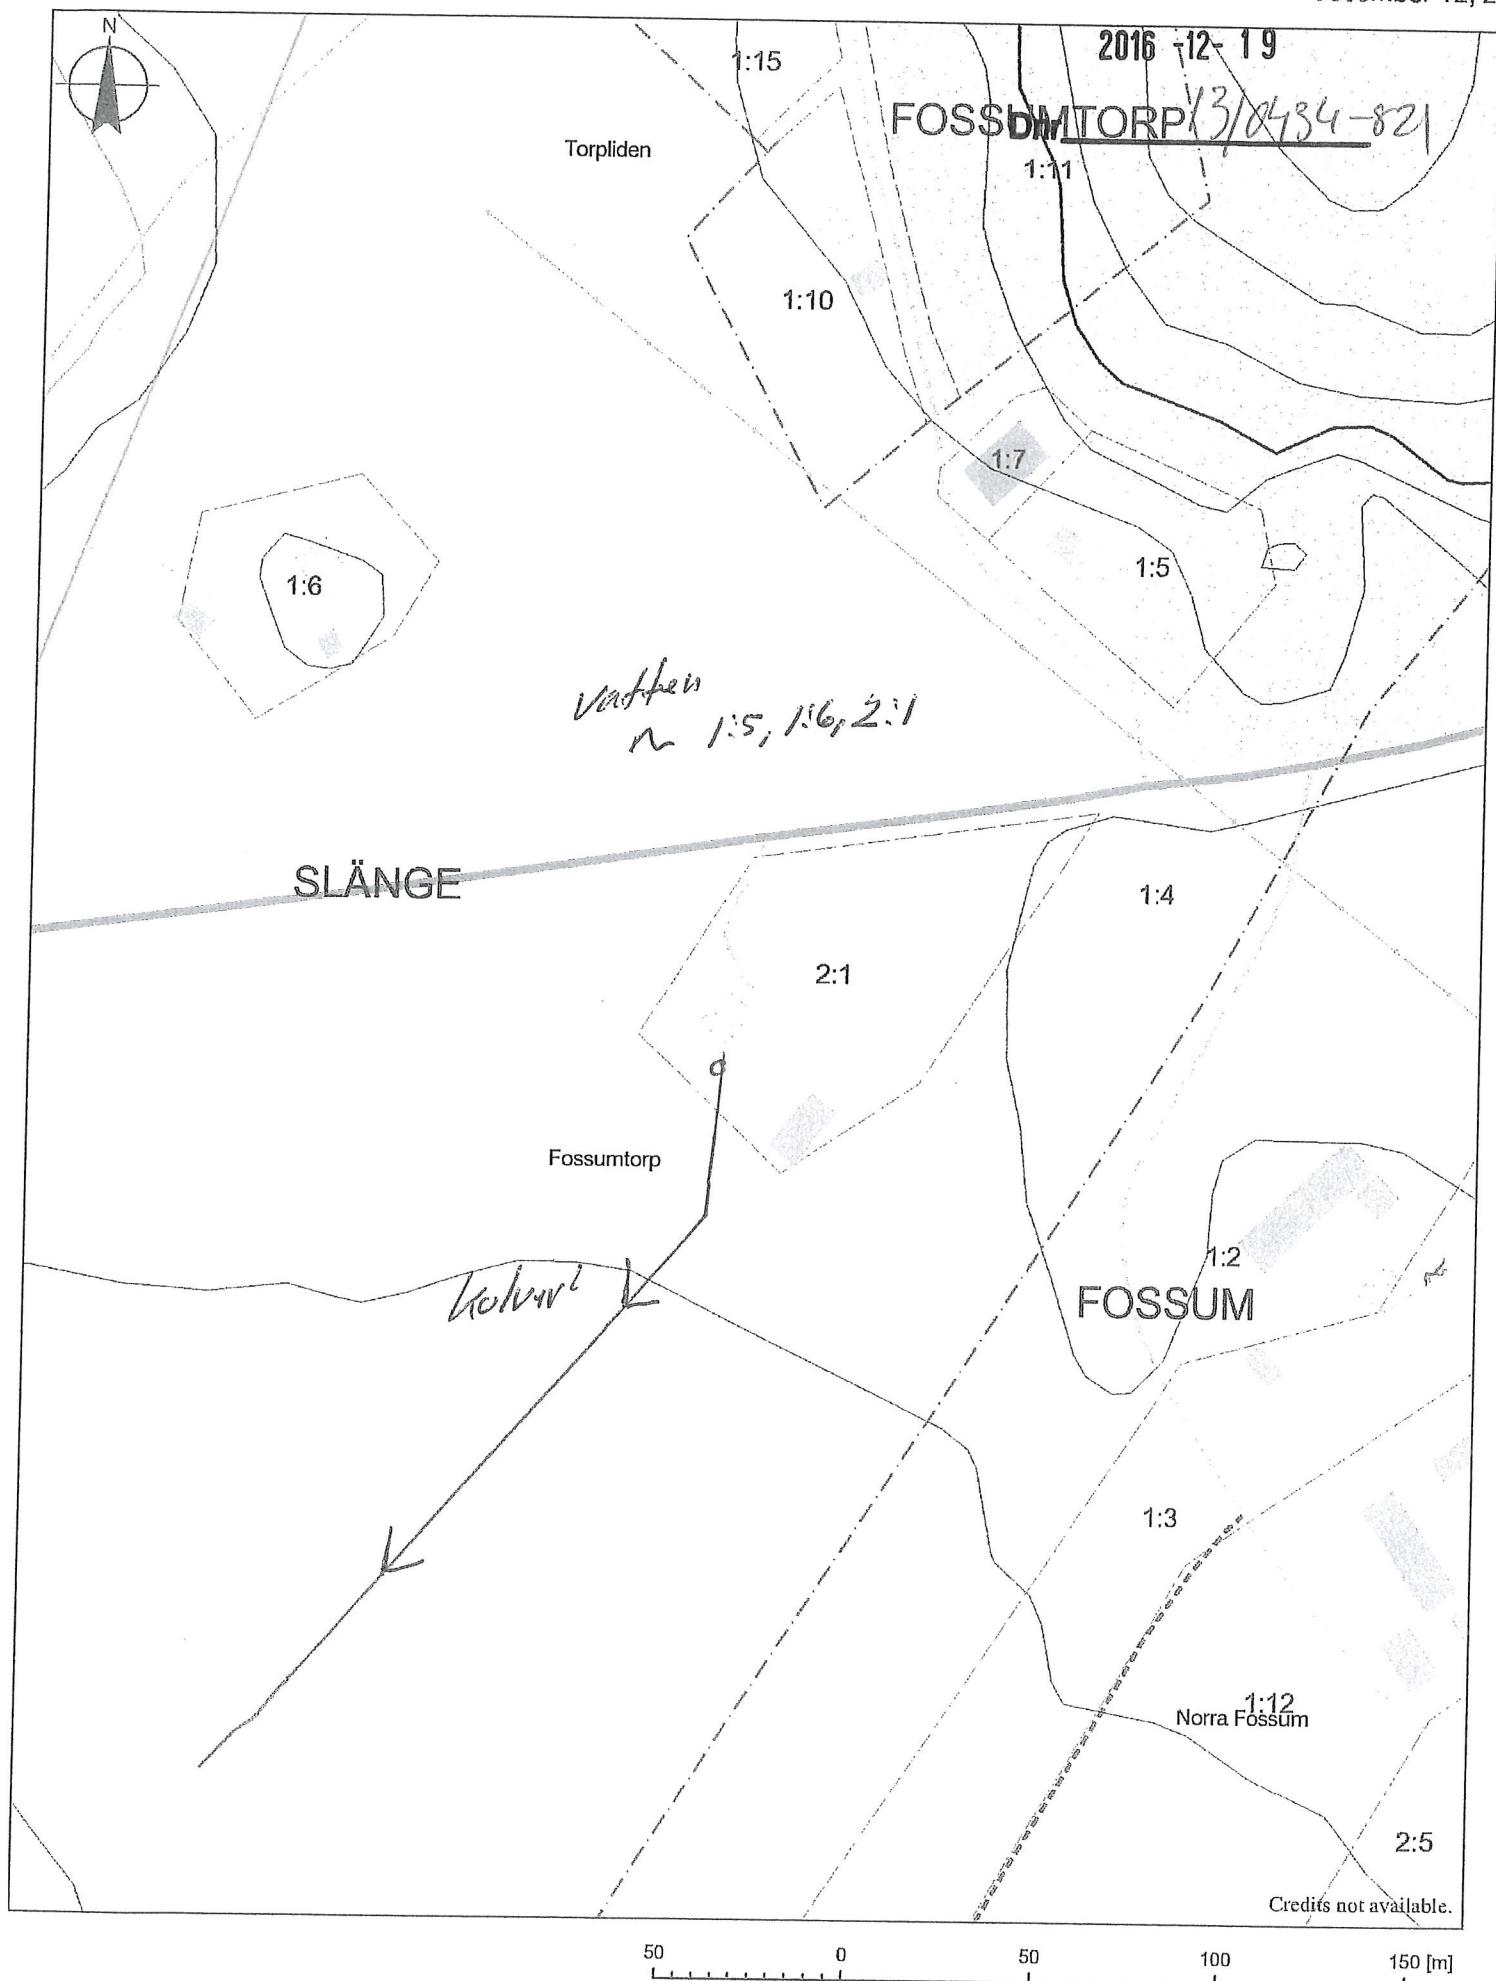




Slänge 2:1

Tanums kommun

december 12, 2016

2016 -12- 19

Dnr 13/0431-821

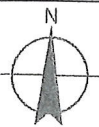

38 m *vatten 1:5, 1:6, 2:1*

1:4

2:1

Fossumtorp

ny an l

huv an l

kulvert

Credits not available.

5 0 5 10 15 20 25 30 35 40 45 [m]

1:500