


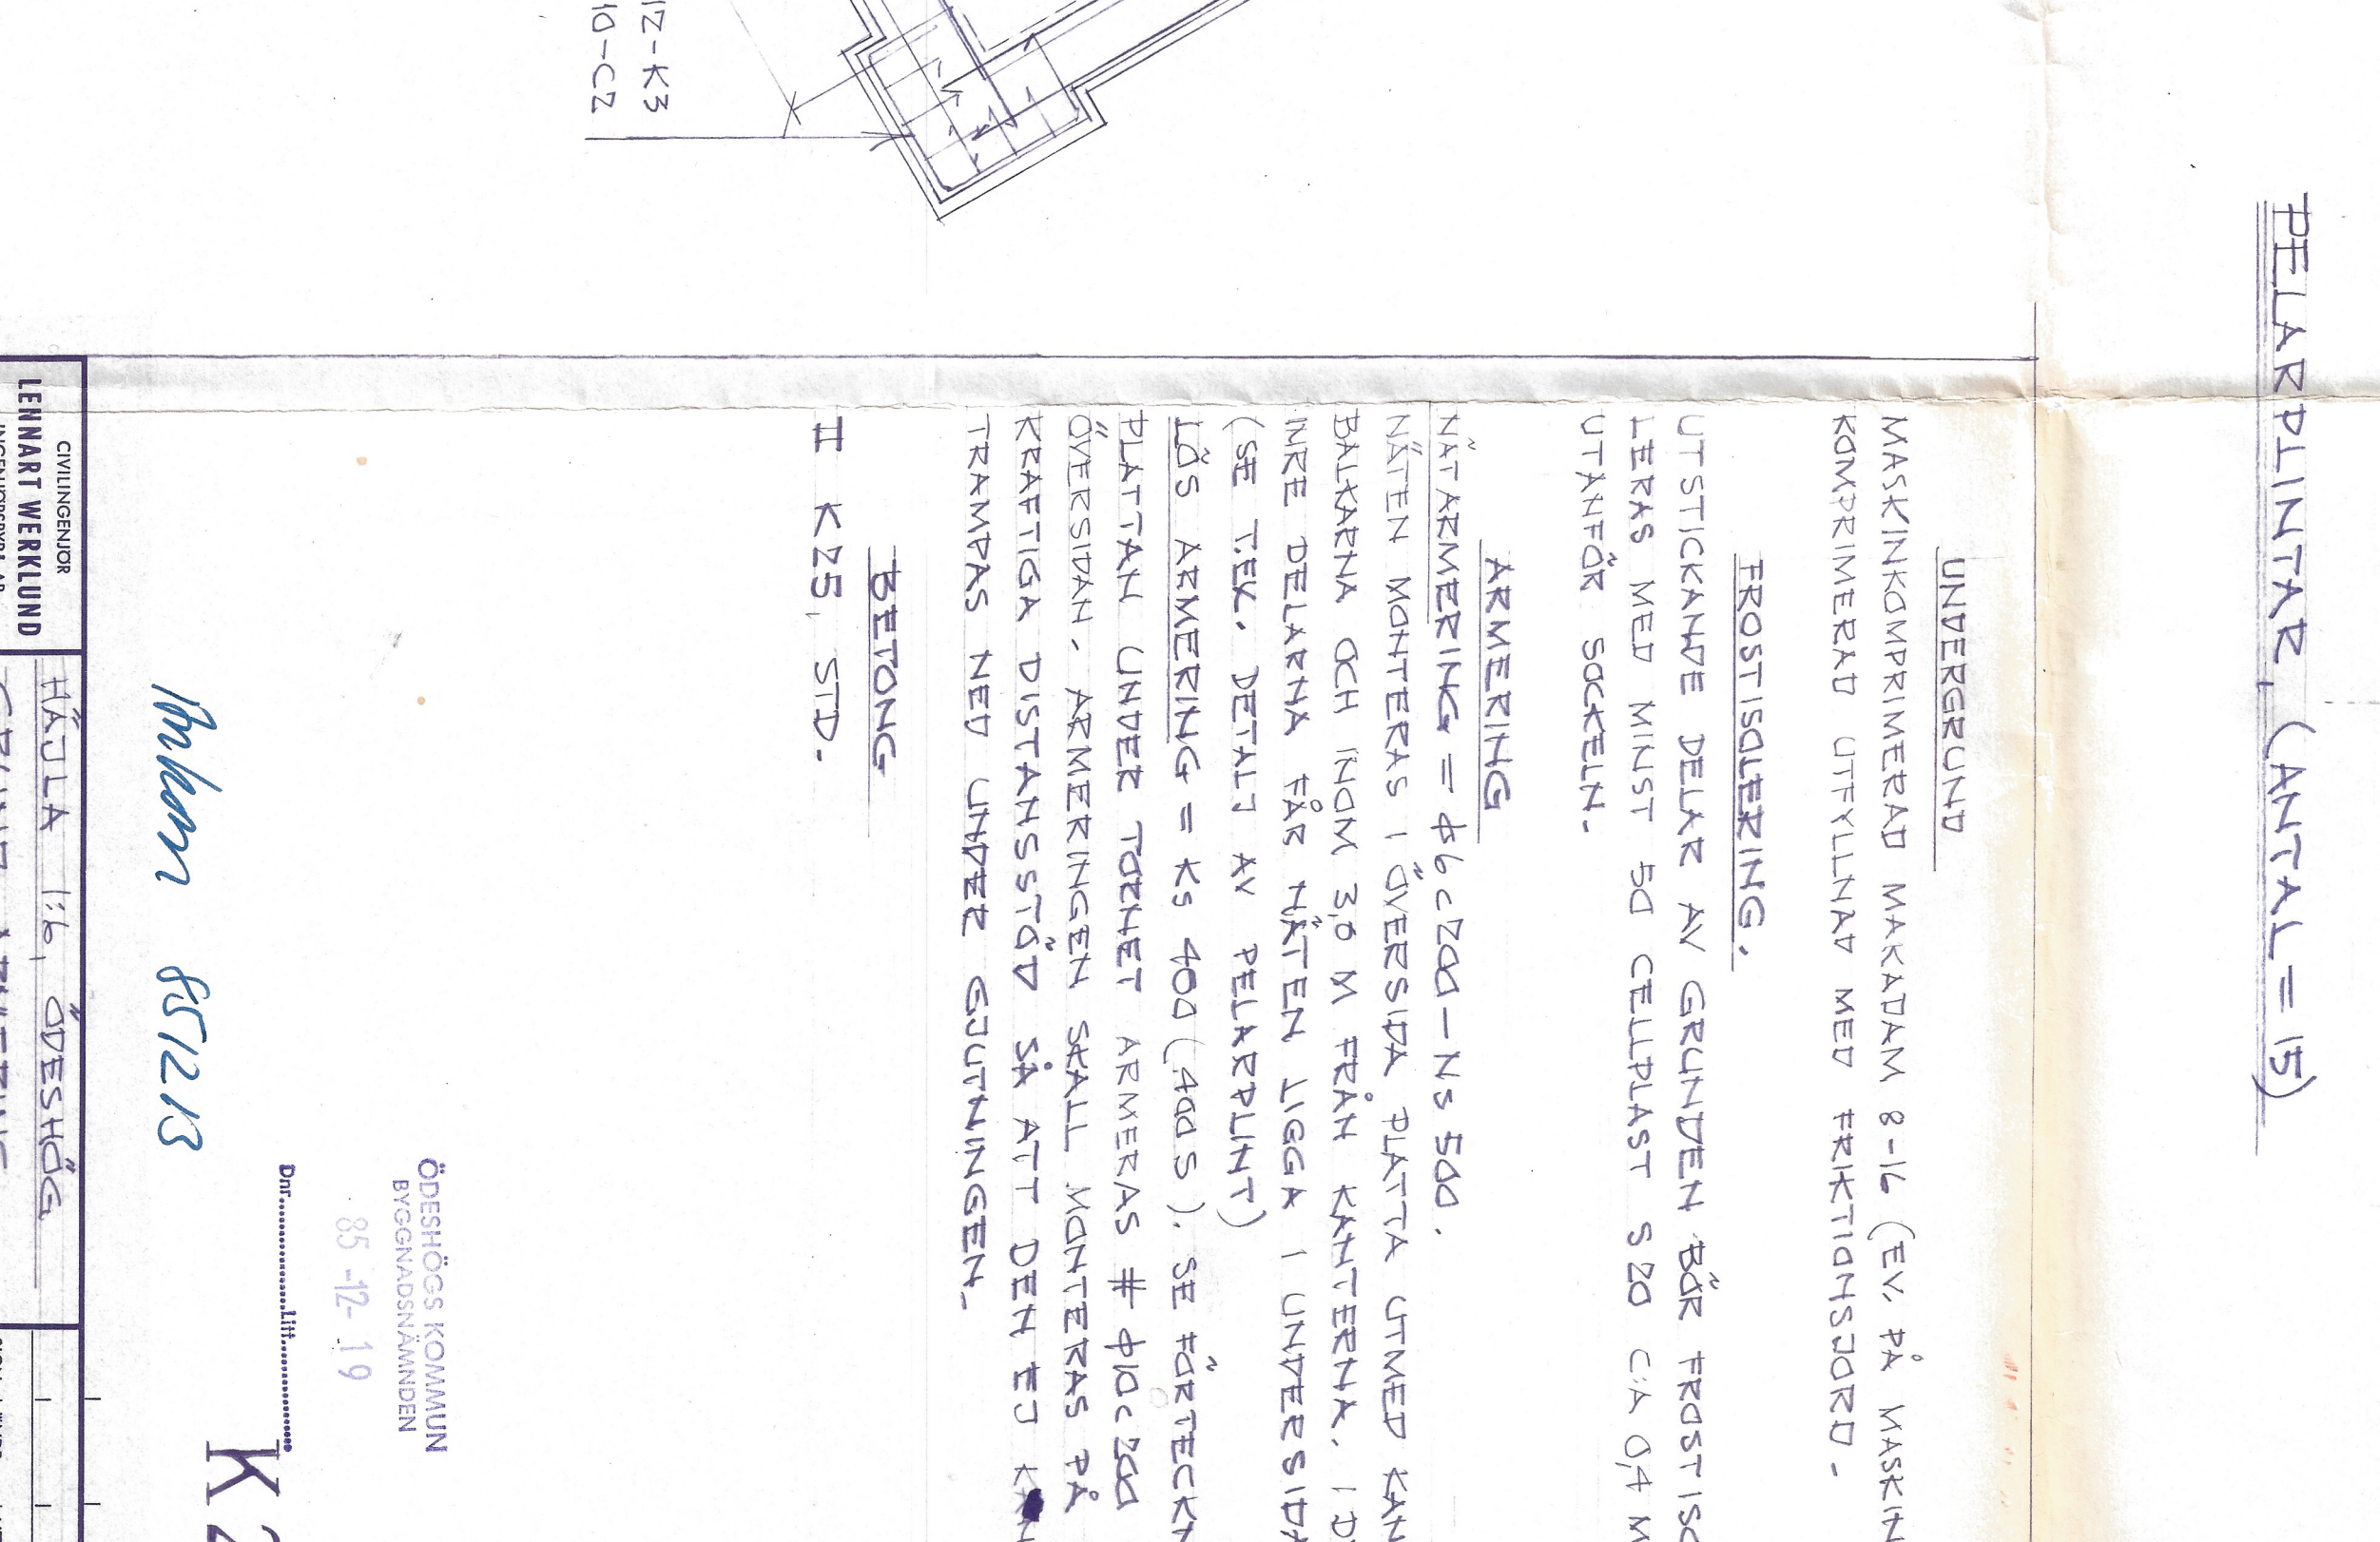
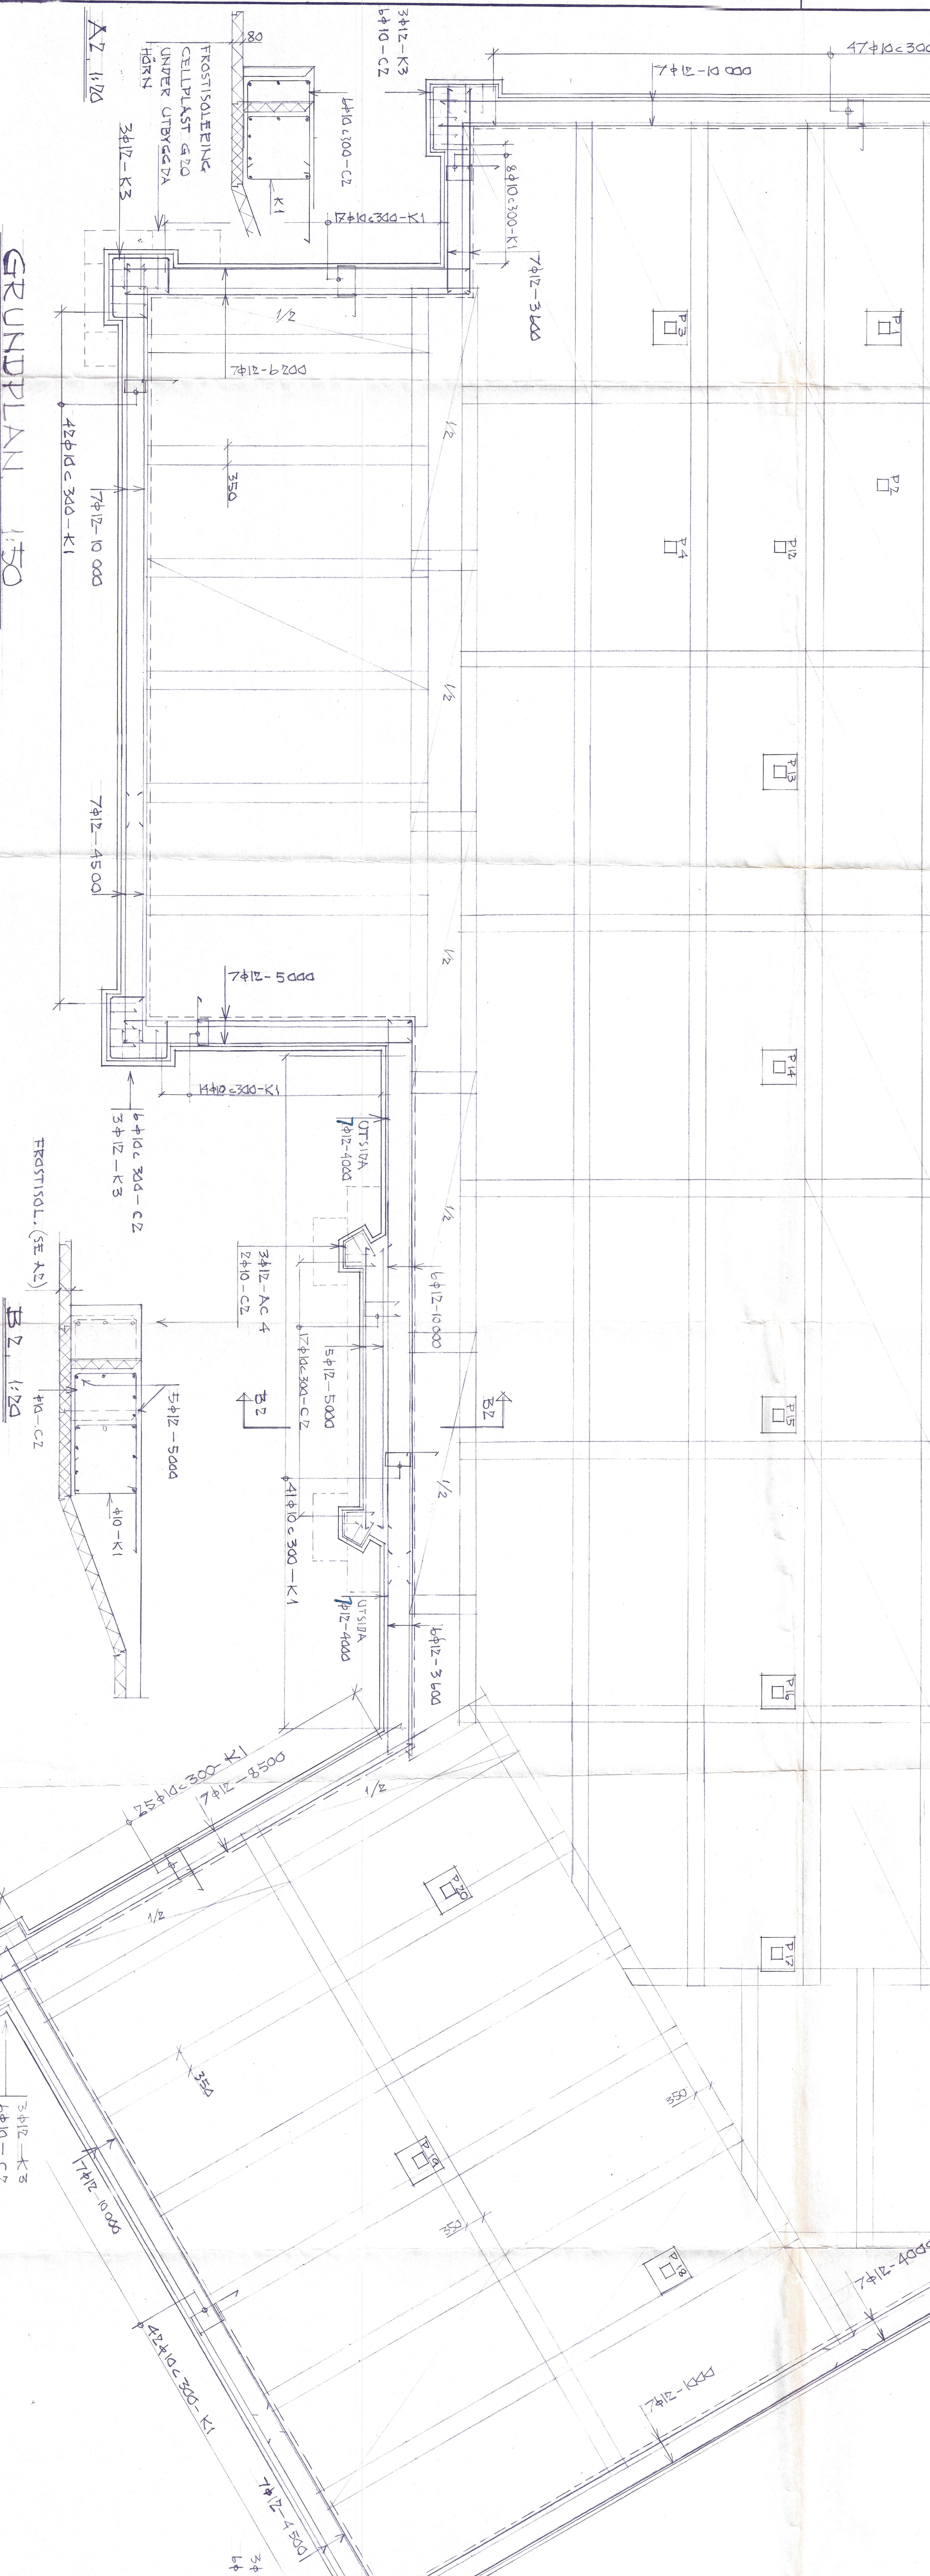
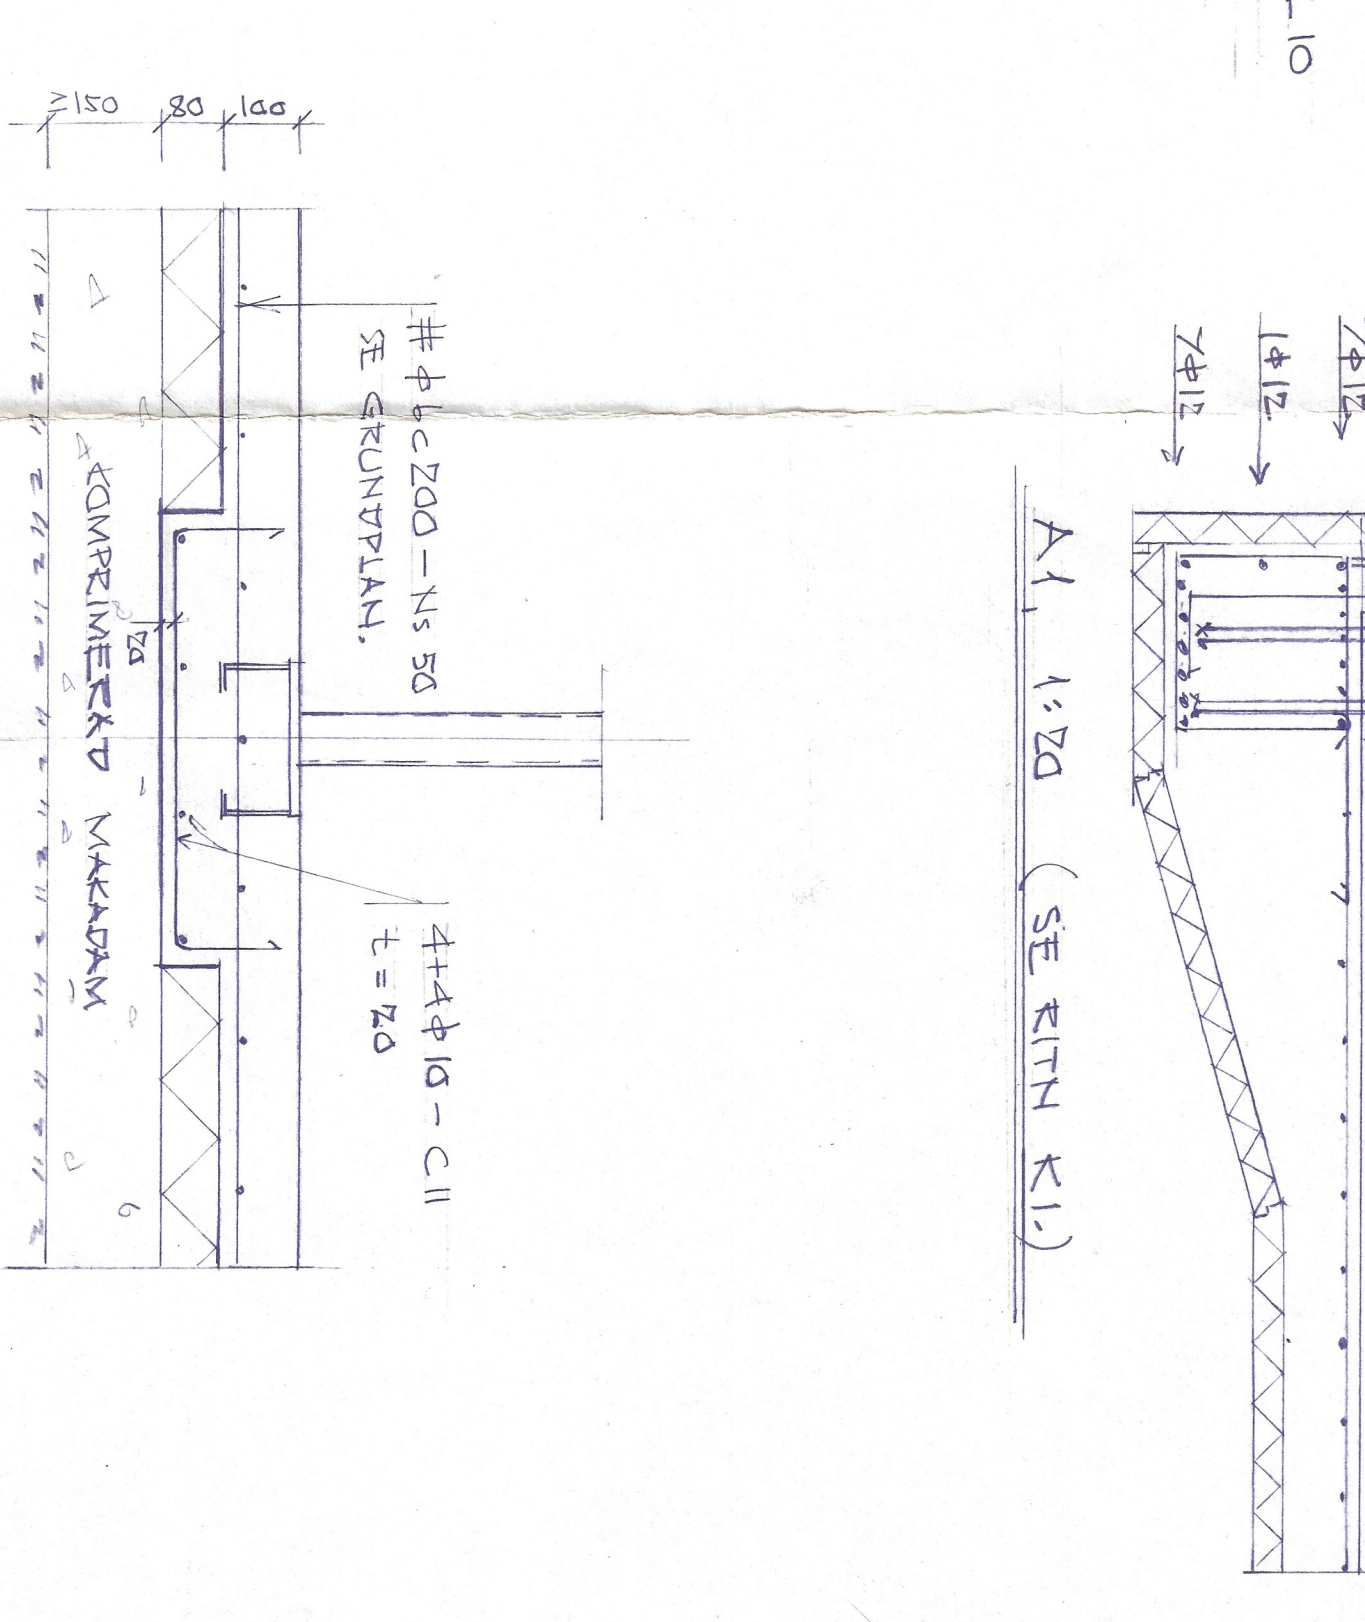
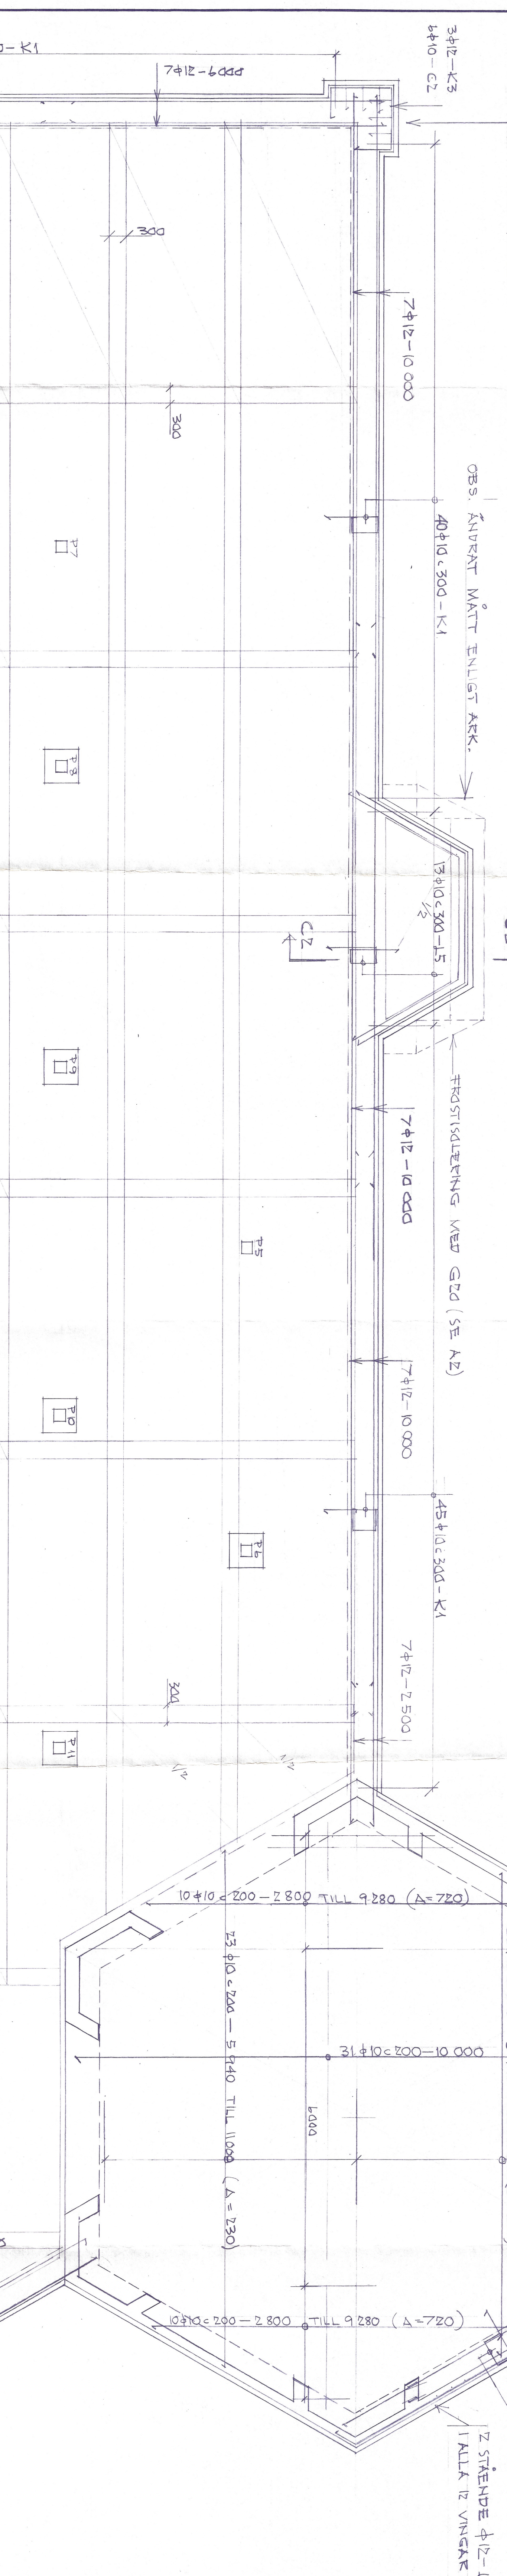
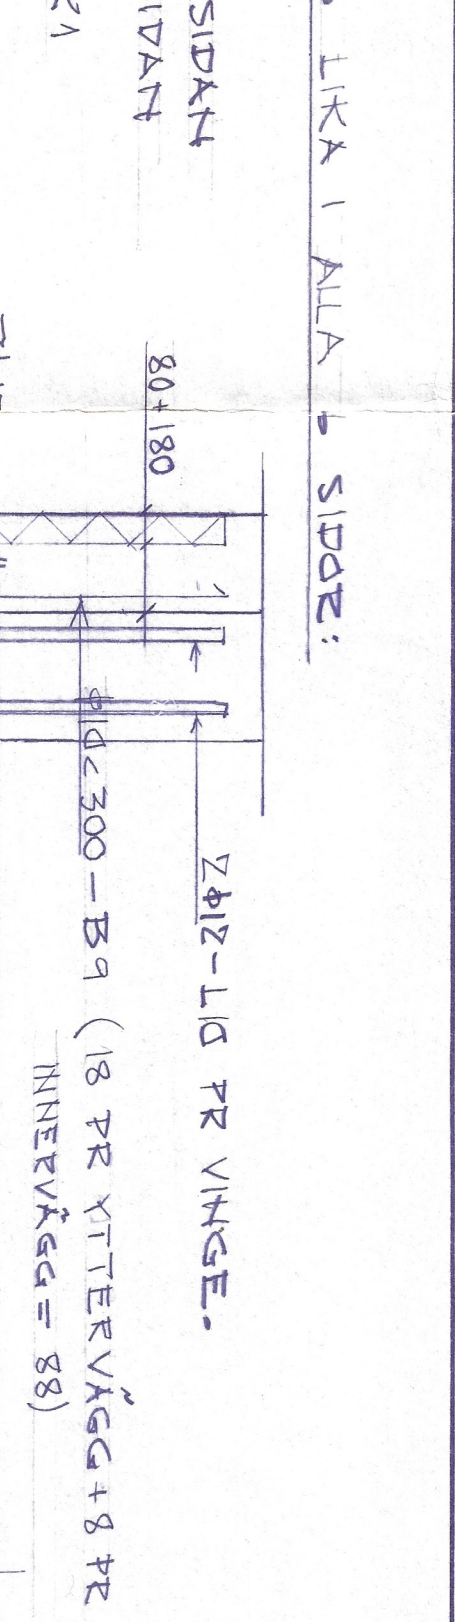
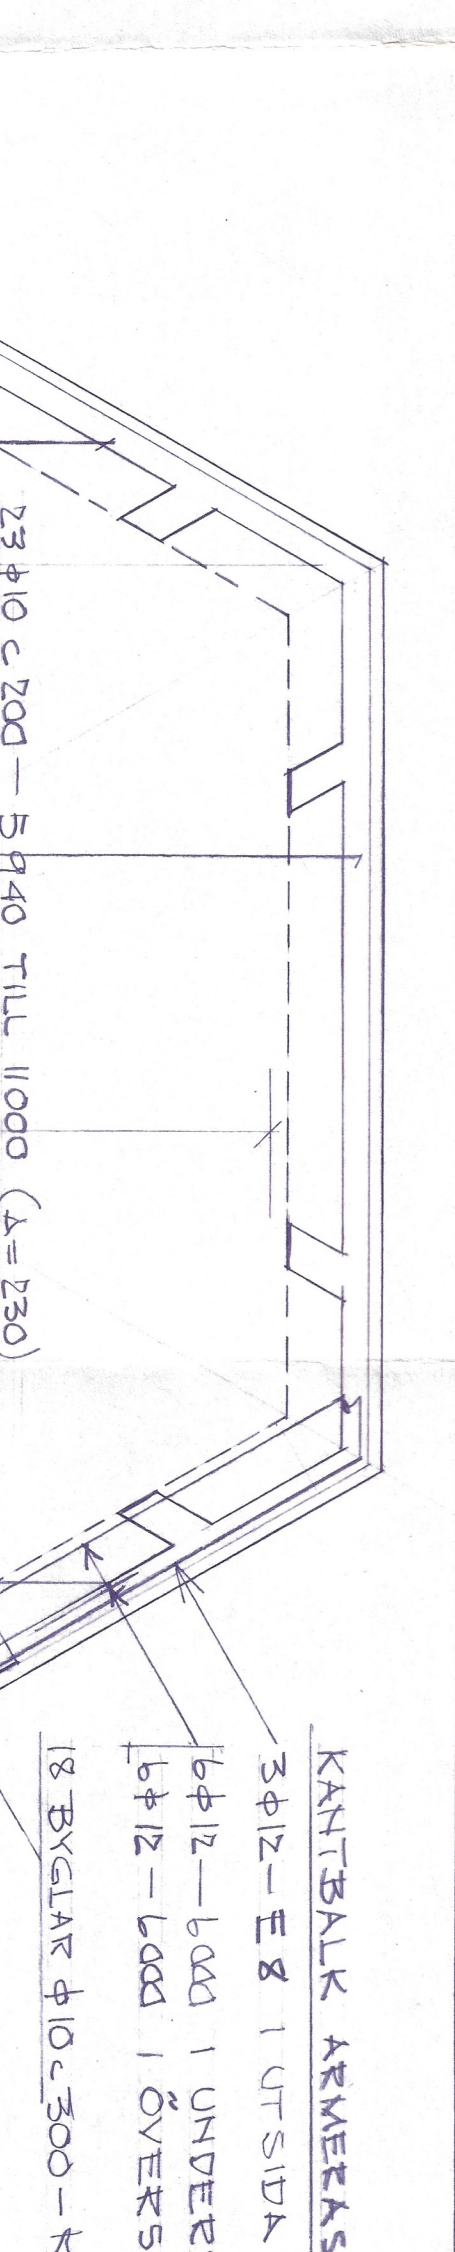
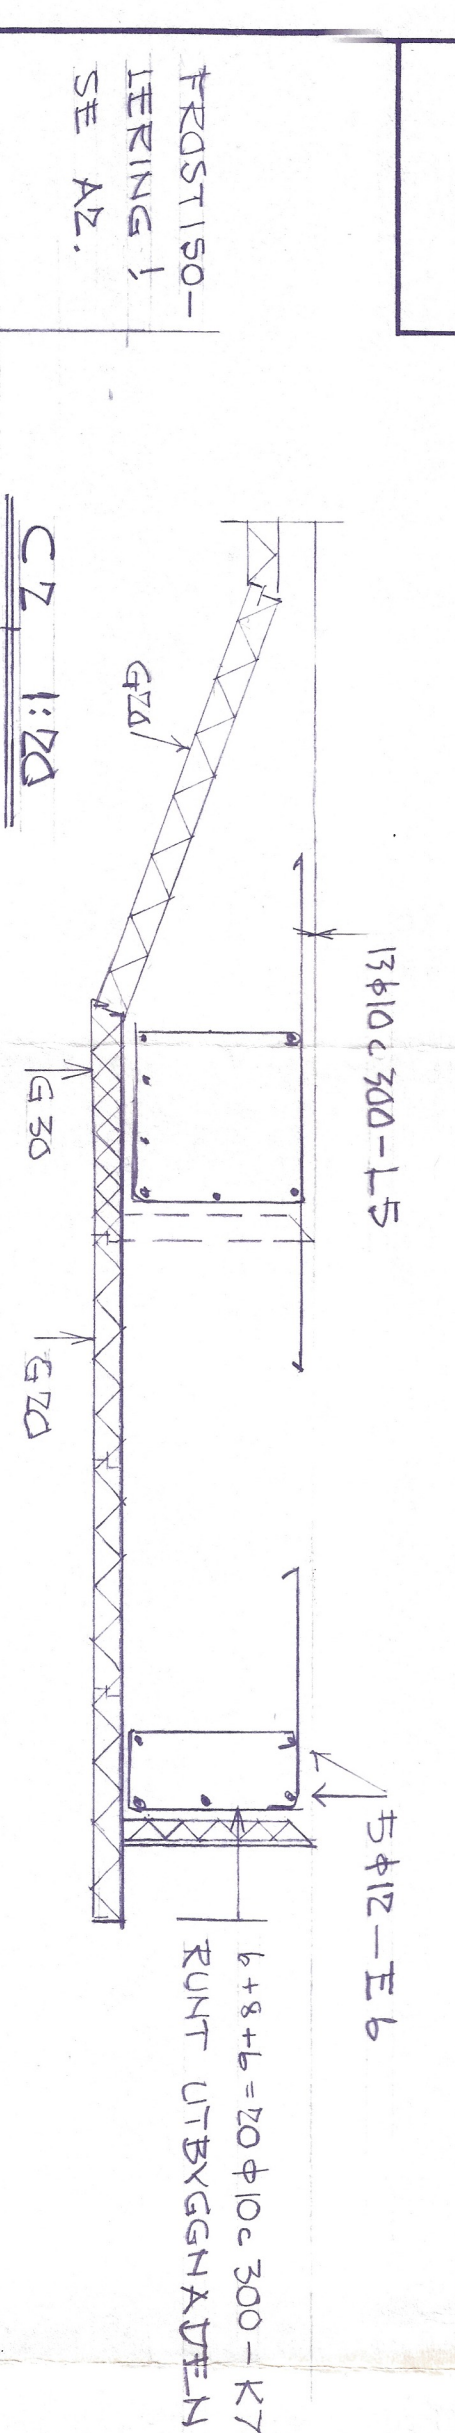
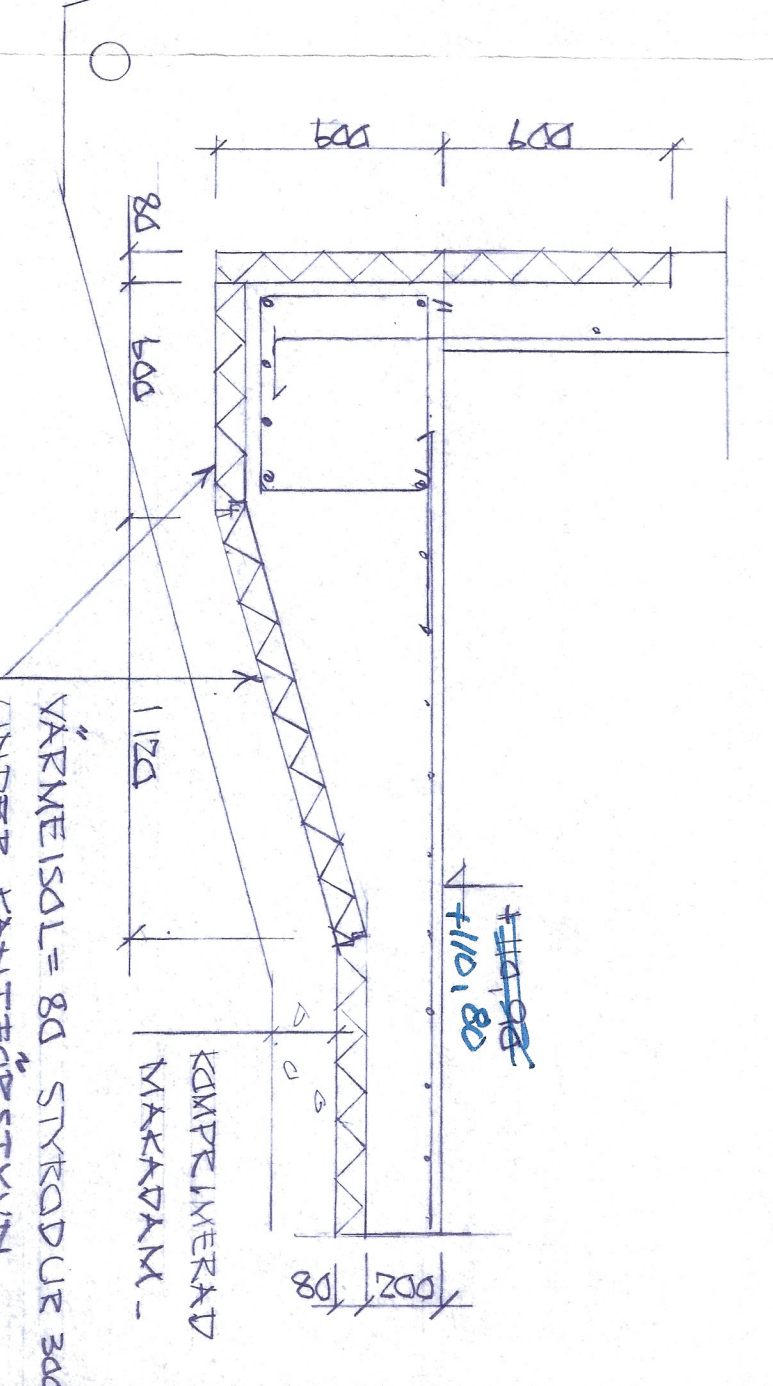
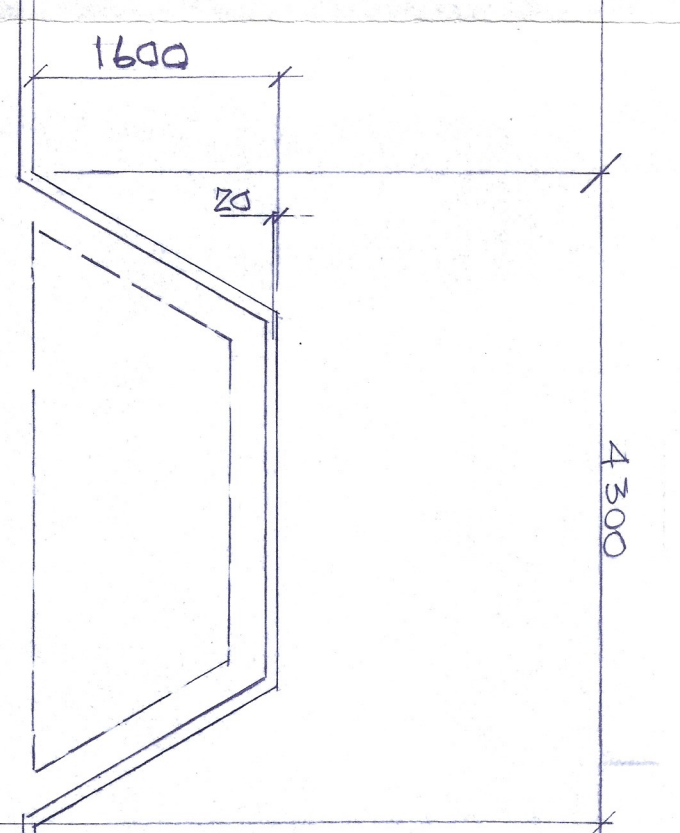


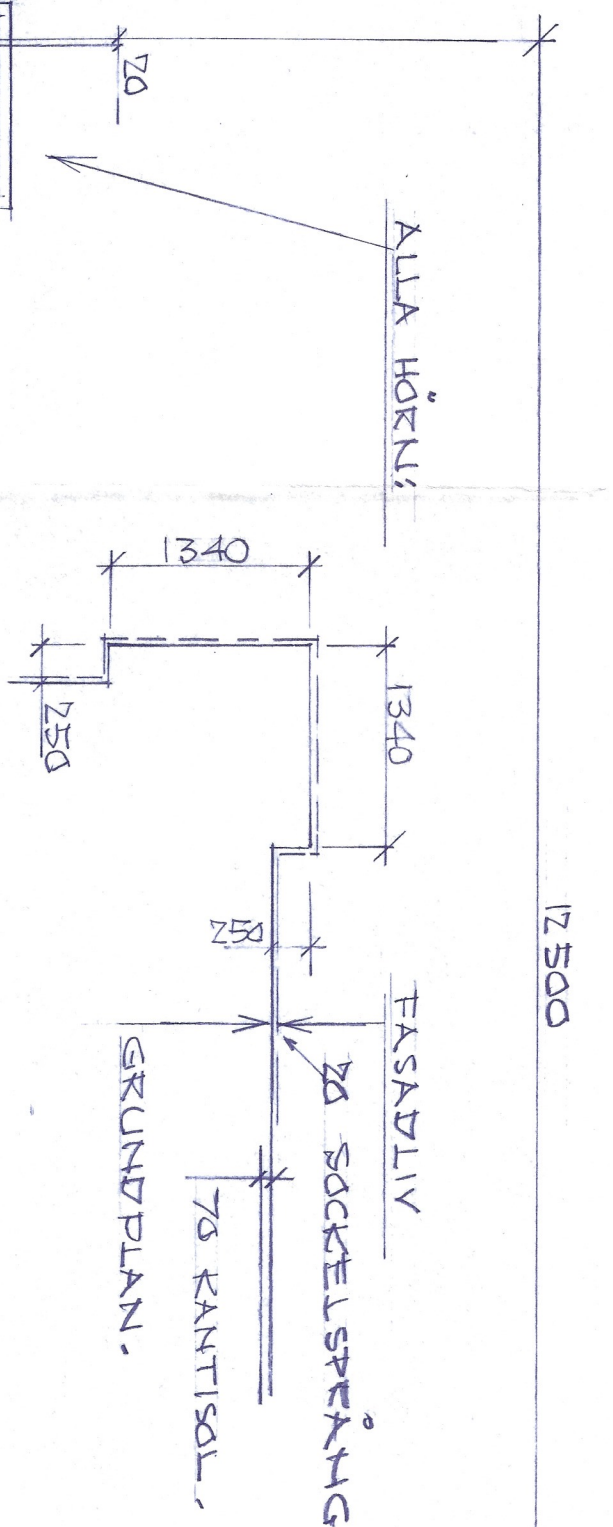


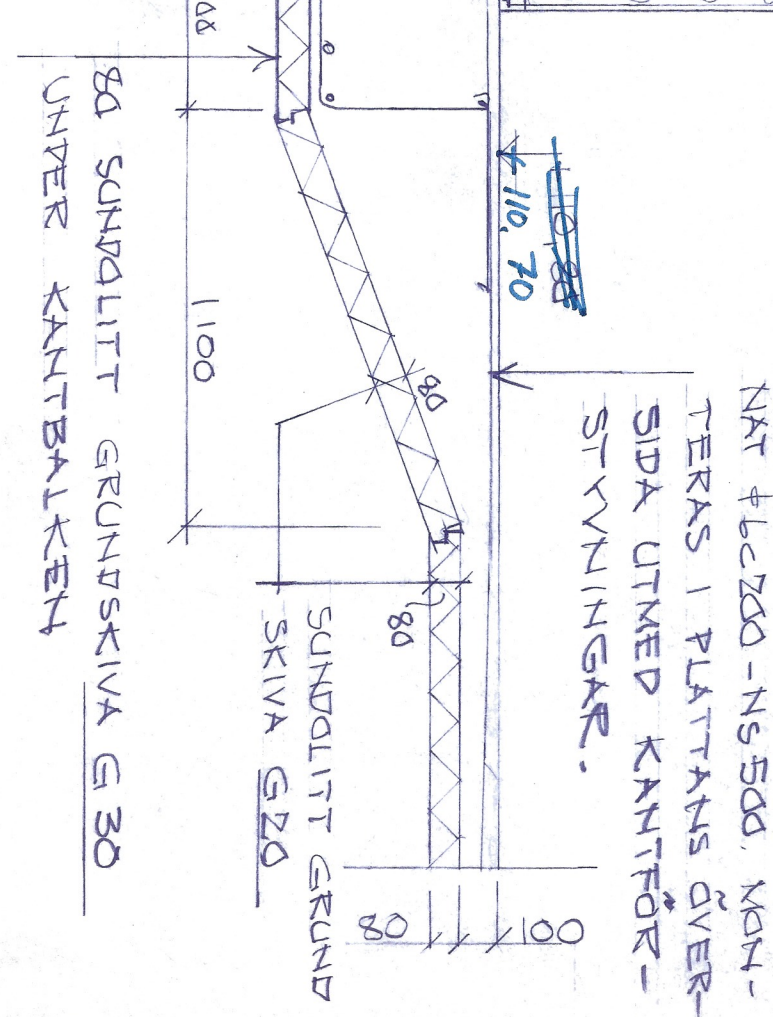

A 1, 1:20

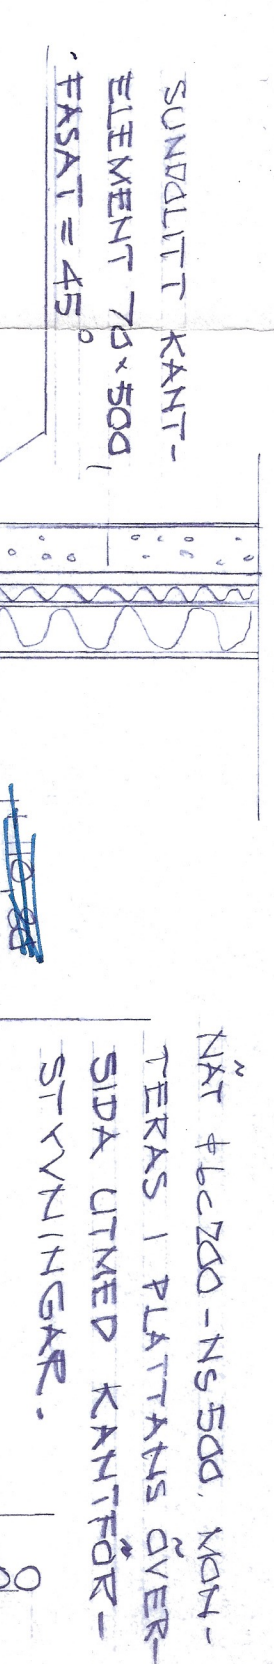

B 1, 1:20

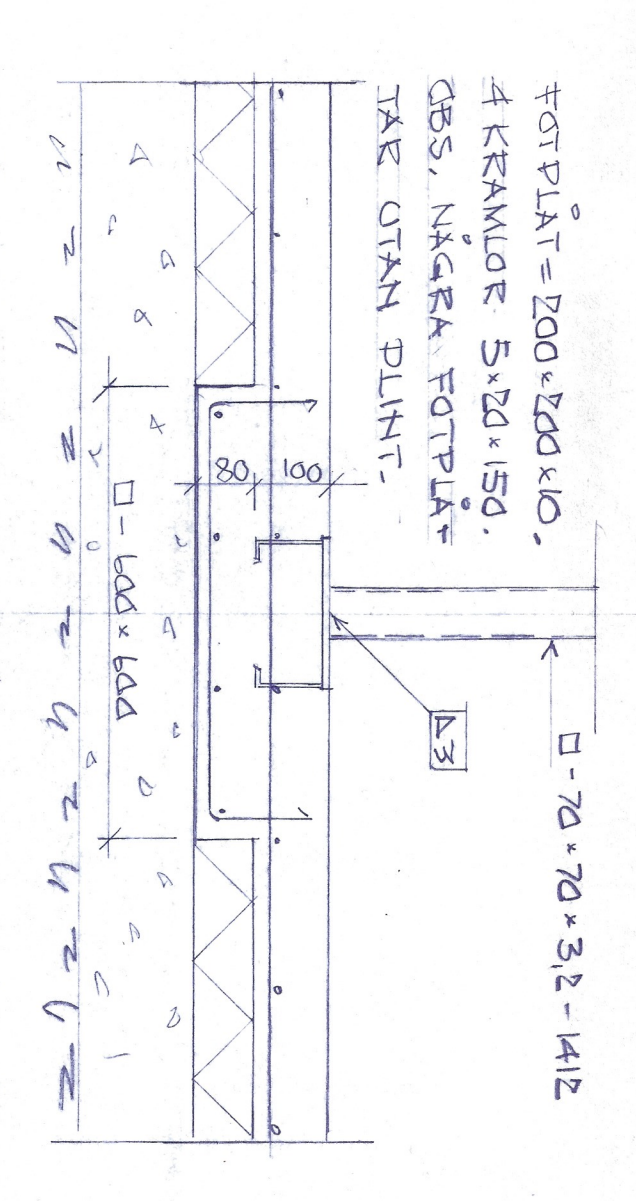

PELLEPLINTAR (ÅNTRAL=15) 1:10

Rev. 1985-12-10
+ Höjder på plattan

K1 A

GRUNDPLAN, 1:50