



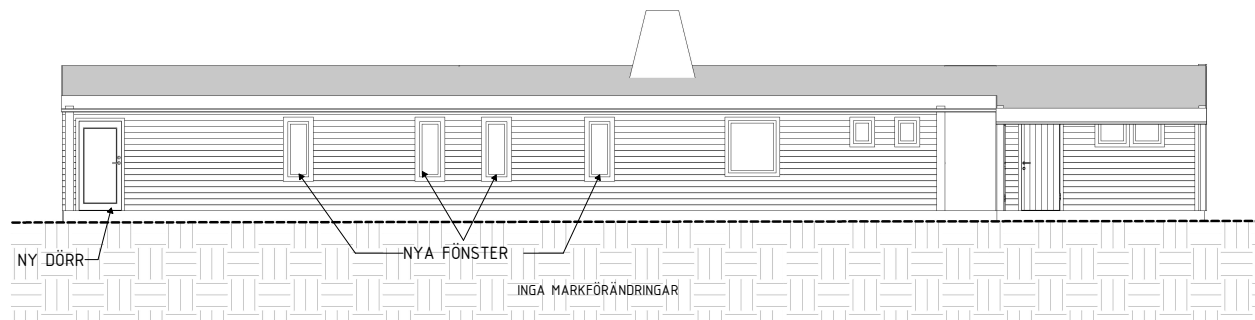


NORDOST

1 : 100

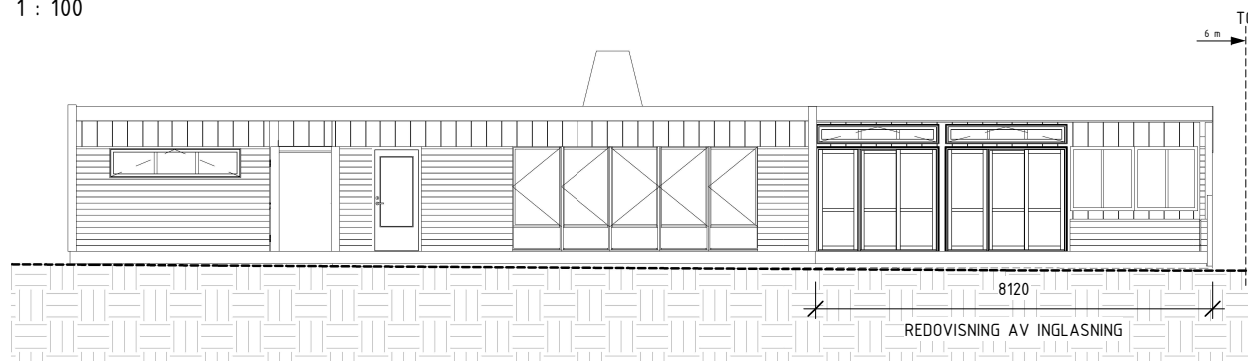


SYDVÄST

1 : 100

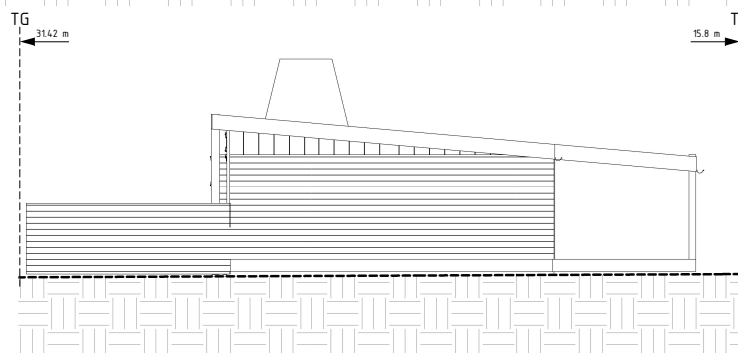





SYDOST

1 : 100

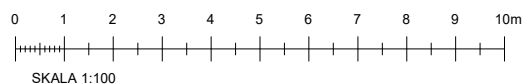

FASADÄNDRING
FASADER
VALL 9:14

SKALA	NUMMER	BET
A3: 1:100	A-40-3-102	

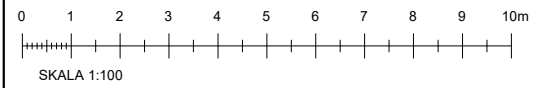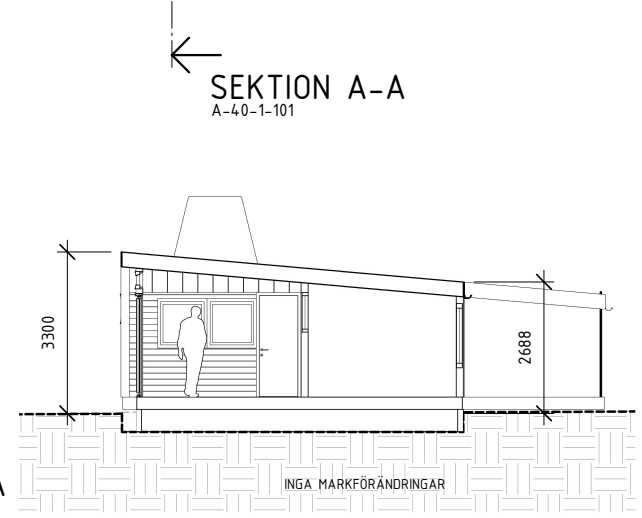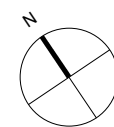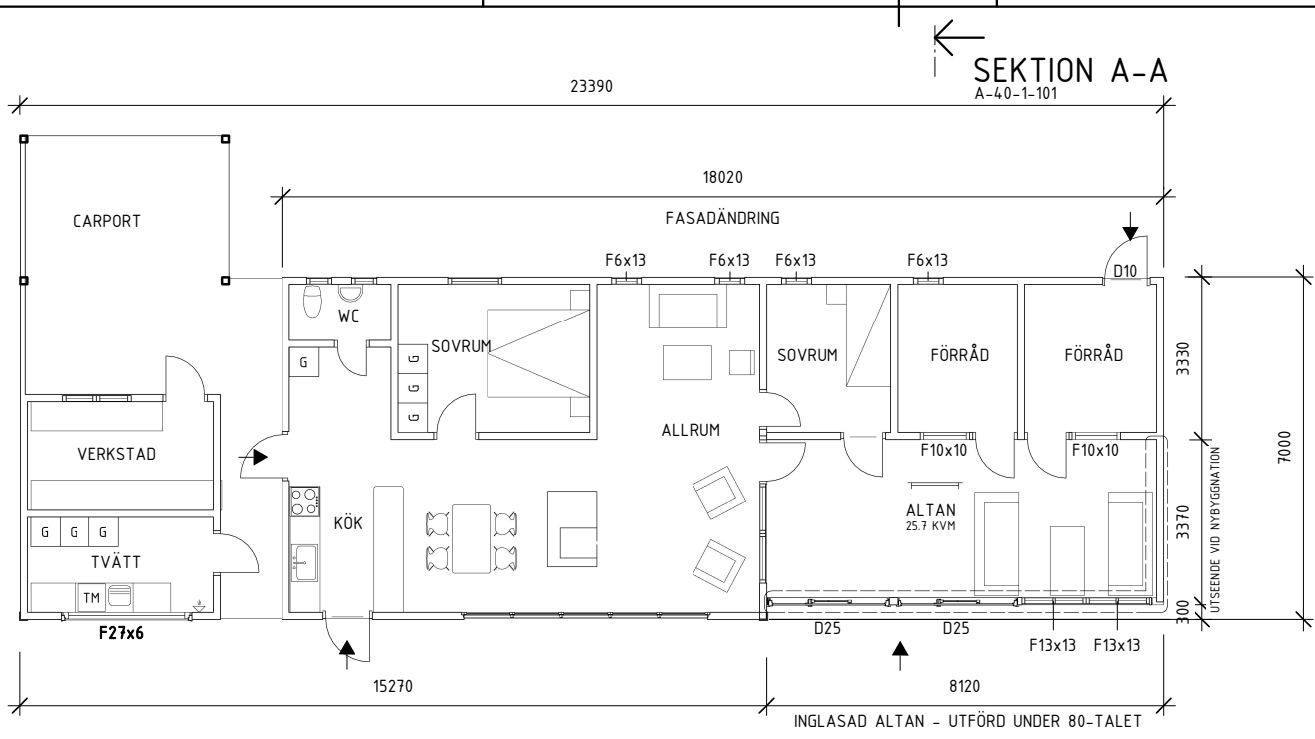

SEKTION A-A
1 : 100

FASADÄNDRING		
PLAN & SEKTION		
VALL 9:14		
SKALA	NUMMER	BET
A3: 1:100	A-40-1-101	