


allsing.

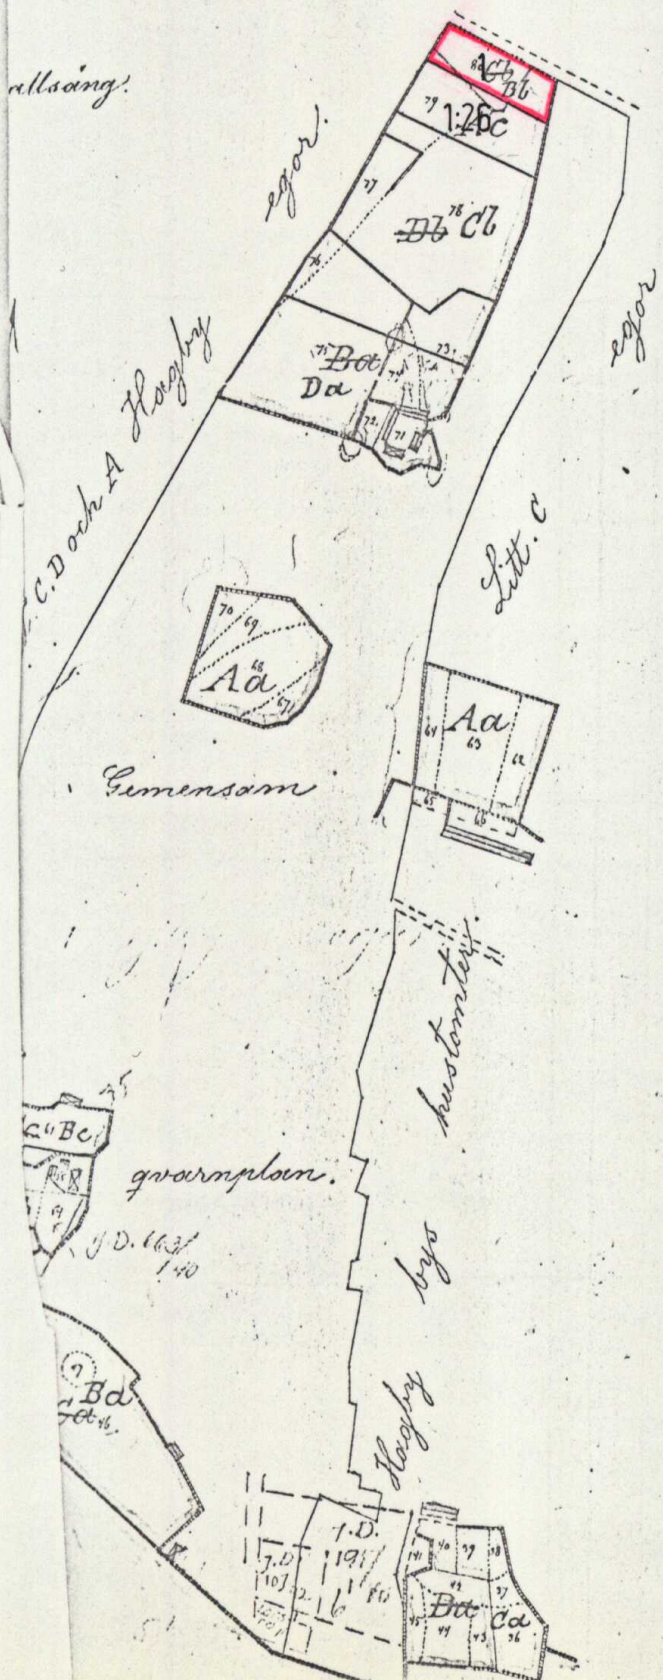

08-NMO⁴-417b