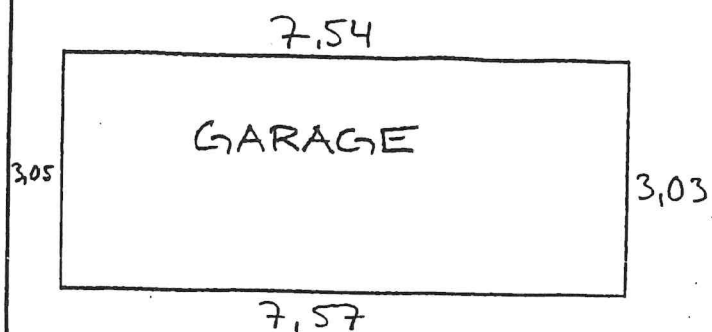
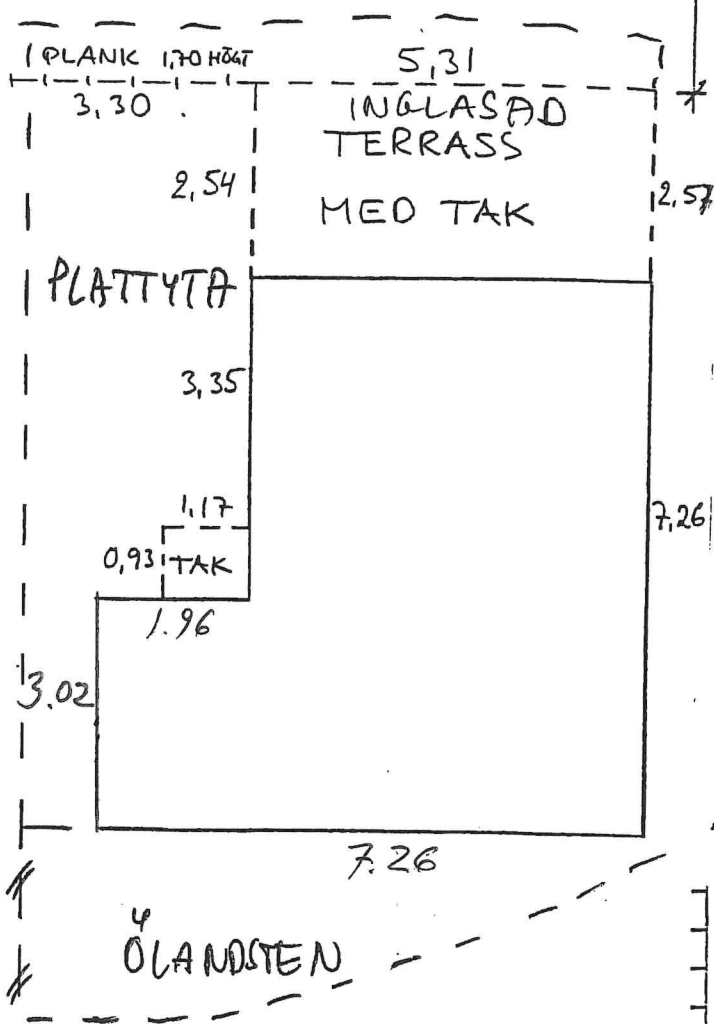


~3,5

YTA

$$7.26 \times 5.28 = 38.33$$

$$3.02 \times 1.96 = 5.92$$

$$5.31 \times 2.56 = 13.59$$

57.84 m²GARAGE

$$7.56 \times 3.04 = \underline{\underline{22.98 \text{ m}^2}}$$

YSTADS KOMMUN  **TEKNIK O FASTIGHET**

Rev

Rev

Kontraktsbilaga 1

Skala 1:100

Rev

Ritad av

Datum

Arrendeställe

Fördragare


Arrendator

06/11/23

TILLBYGGNAD

040220

Orion 1

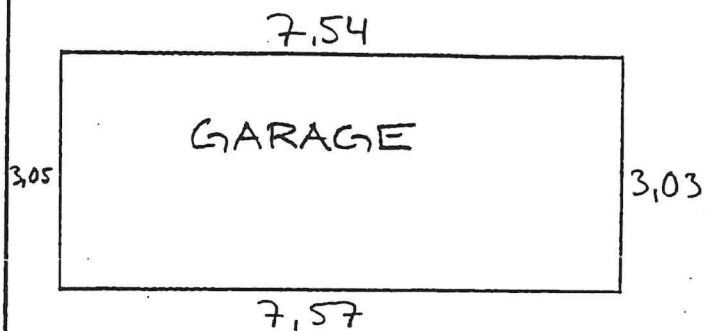

~8,0

~3,5

YTA

$7,26 \times 5,28 = 38,33$

$2,98 \times 1,00 = 2,98$


$1,17 \times 0,93 = 1,09$

$5,31 \times 2,56 = 13,59$

55,99M²

GARAGE

$7,56 \times 3,04 = 22,98M^2$

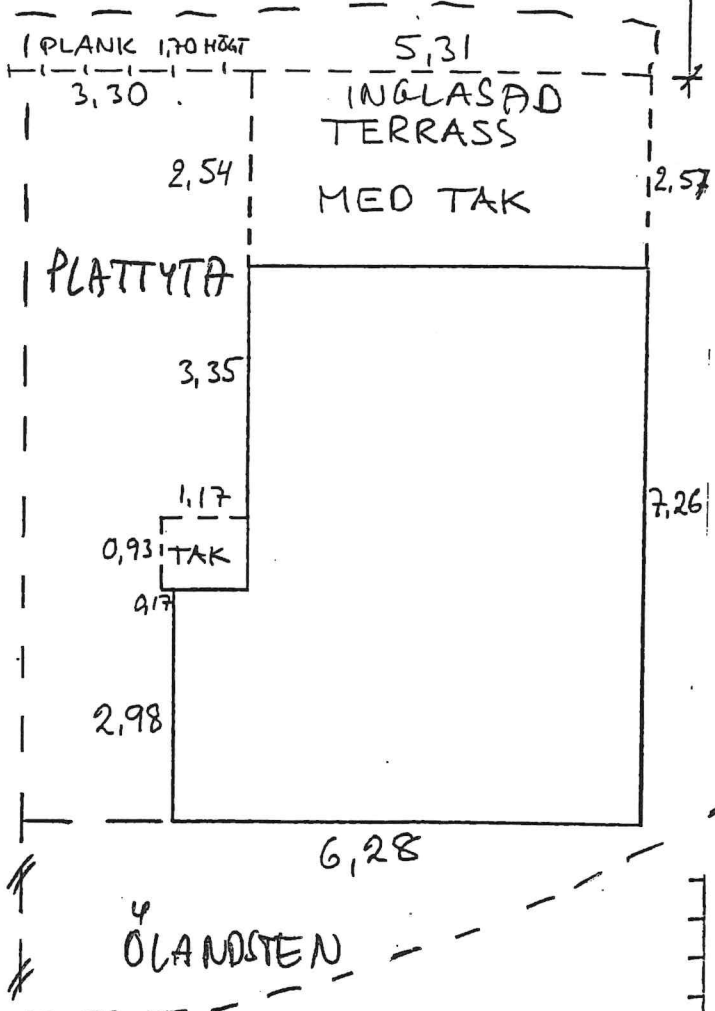

YSTADS KOMMUN  TEKNIK O FASTIGHET		Rev	
		Rev	
Kontraktsbilaga 1	Skala 1:100	Rev	
Ritad av <i>L.K.</i>	Datum <i>040220</i>	Arrendeställe <i>Orion 1</i>	

Stigge Rickard Widen Joakim Wydeen