


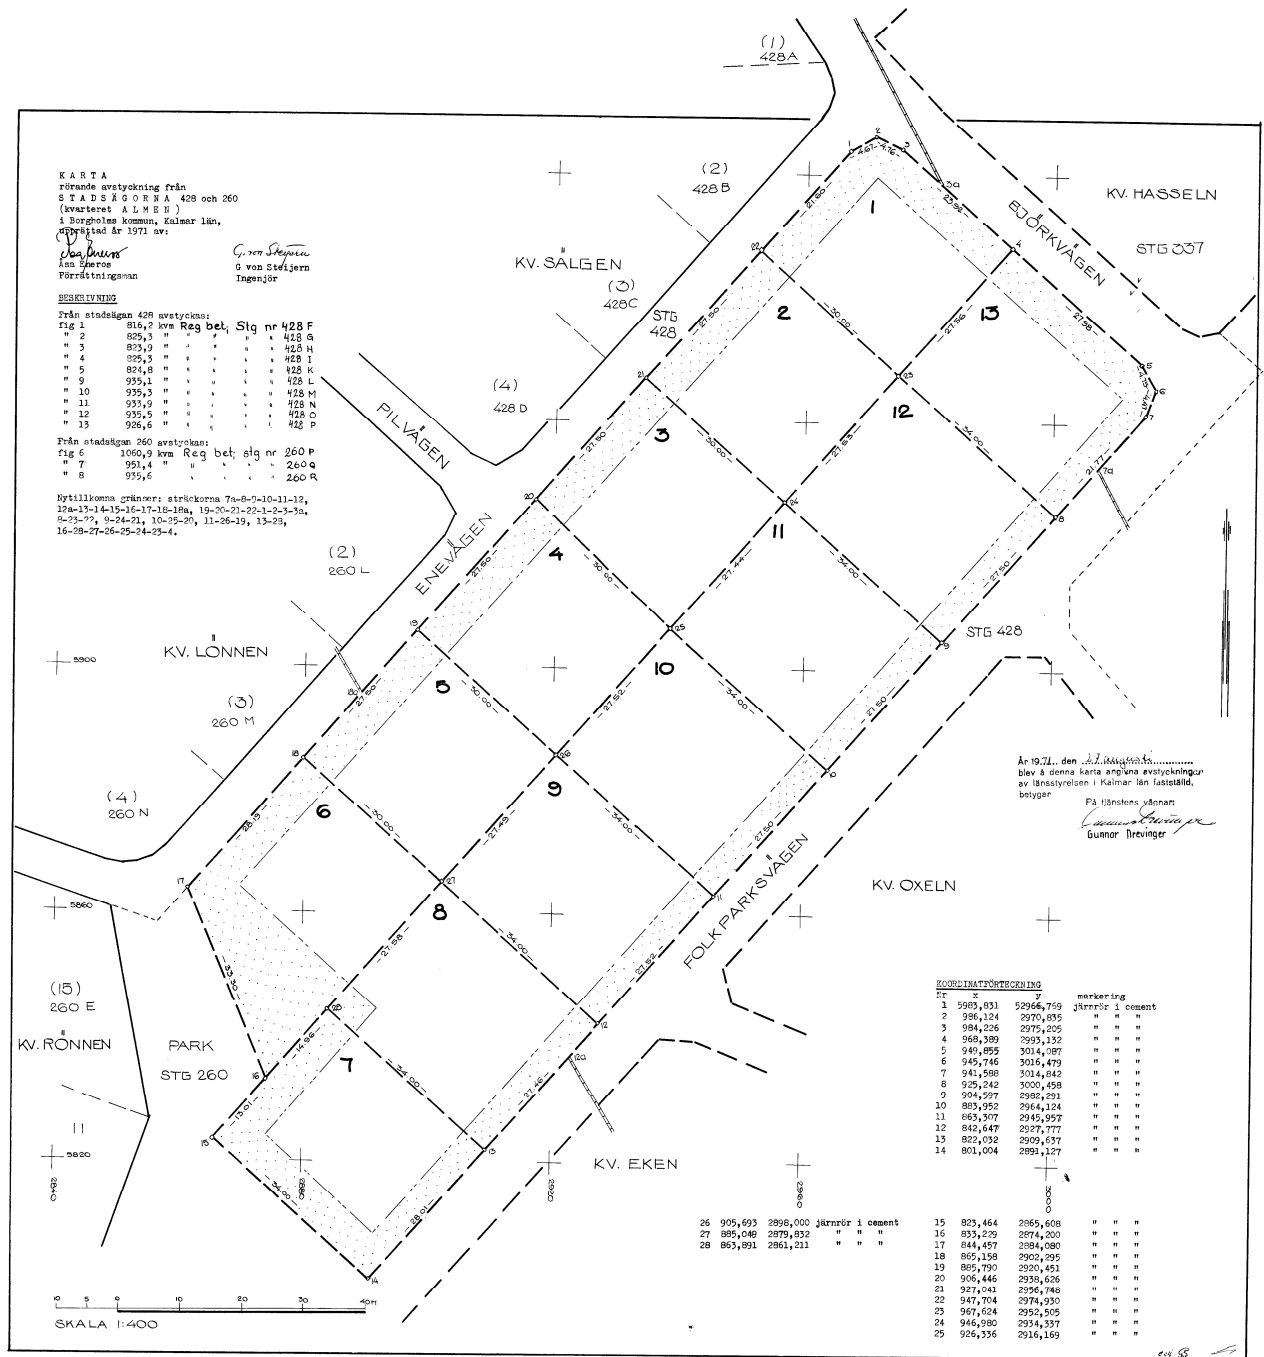

0885-950 Pm