


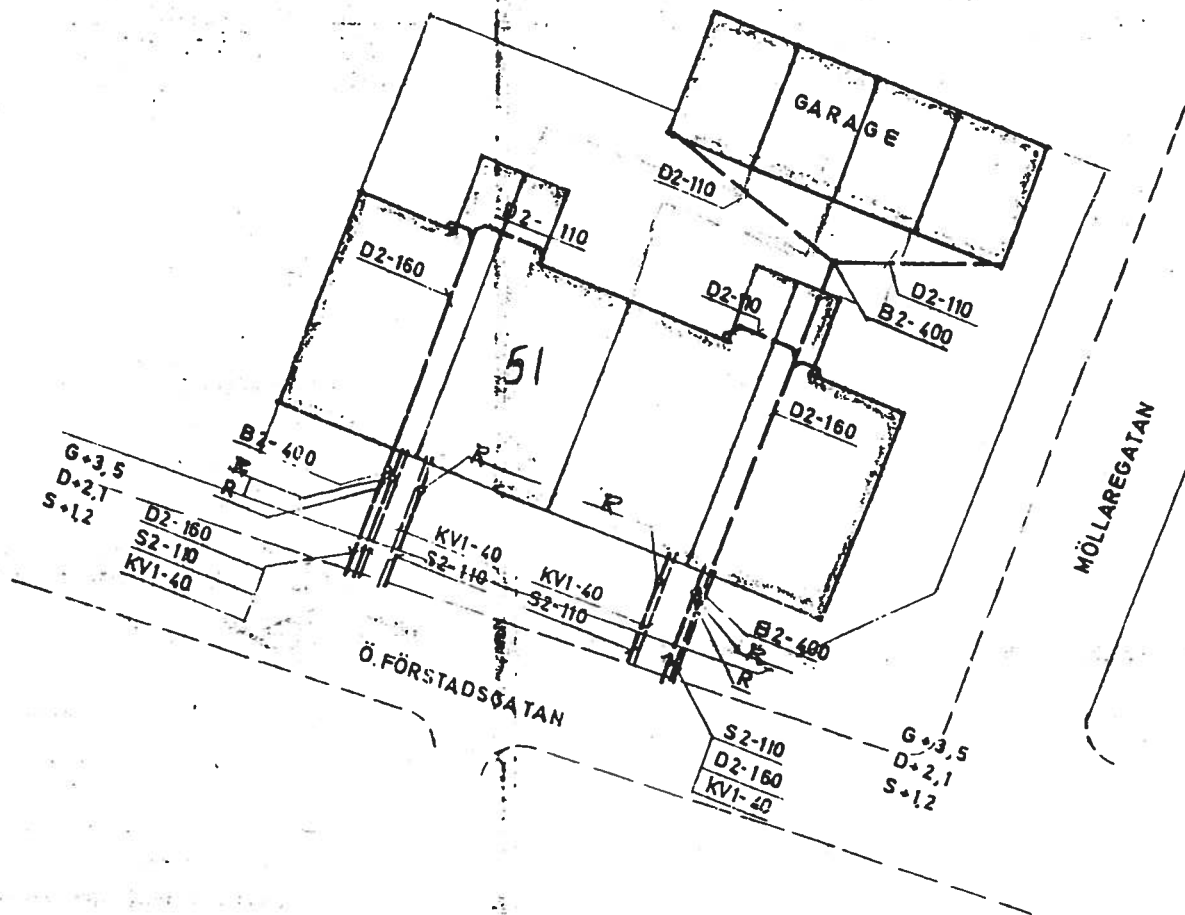

SITUATIONSPLAN
Skala 1:400