


FASAD PANEL : NCS: S-0502-Y S  
 TAK TEGELPANNA NCS: S-9000-N ..  
 SOCKEL: NCS: S-3502-Y..

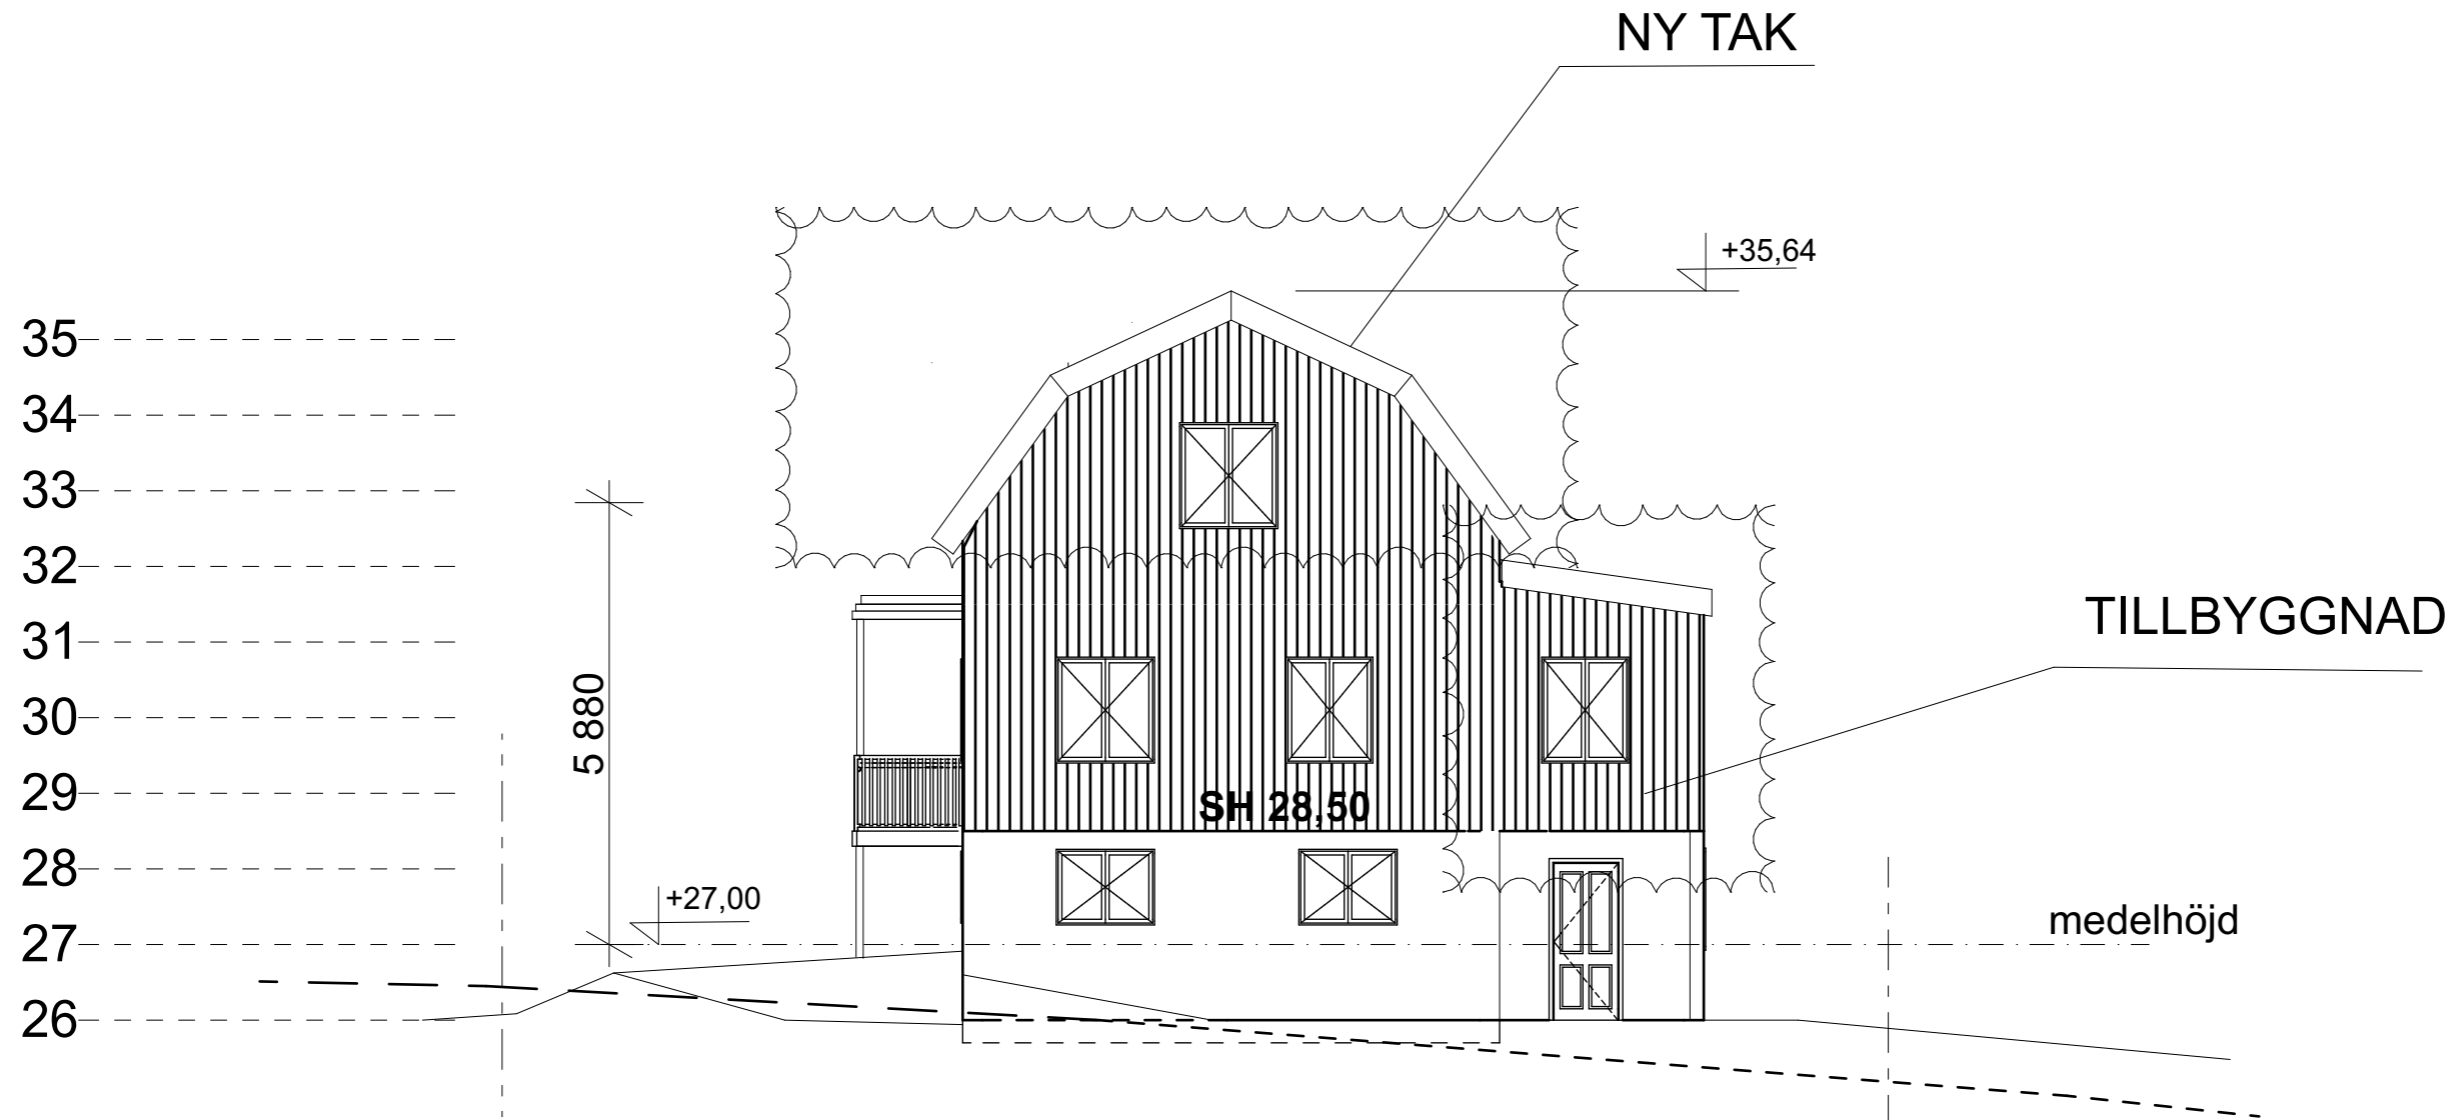

**medelhöjd:**



$$9,8+18,8+6,3+23,5= 58,4/36,8= 1,5 \text{ m1}$$

reviderade 05 dec 21

~~reviderade 02 dec 21~~

FASAD SYDÖST

0 1 2 3 4 5 6 7 8 9 10

 ERFOLG PROJEKT AB	Fastighetsbeteckning: GRANKOTTEN 25	Egare: 	1 : 100
	Adress: Skolgatan 10, 14930, Nynäshamn		316/18

Ritad av:  
Milos Rilakovic 0722527992