



B-lov D 509/800619

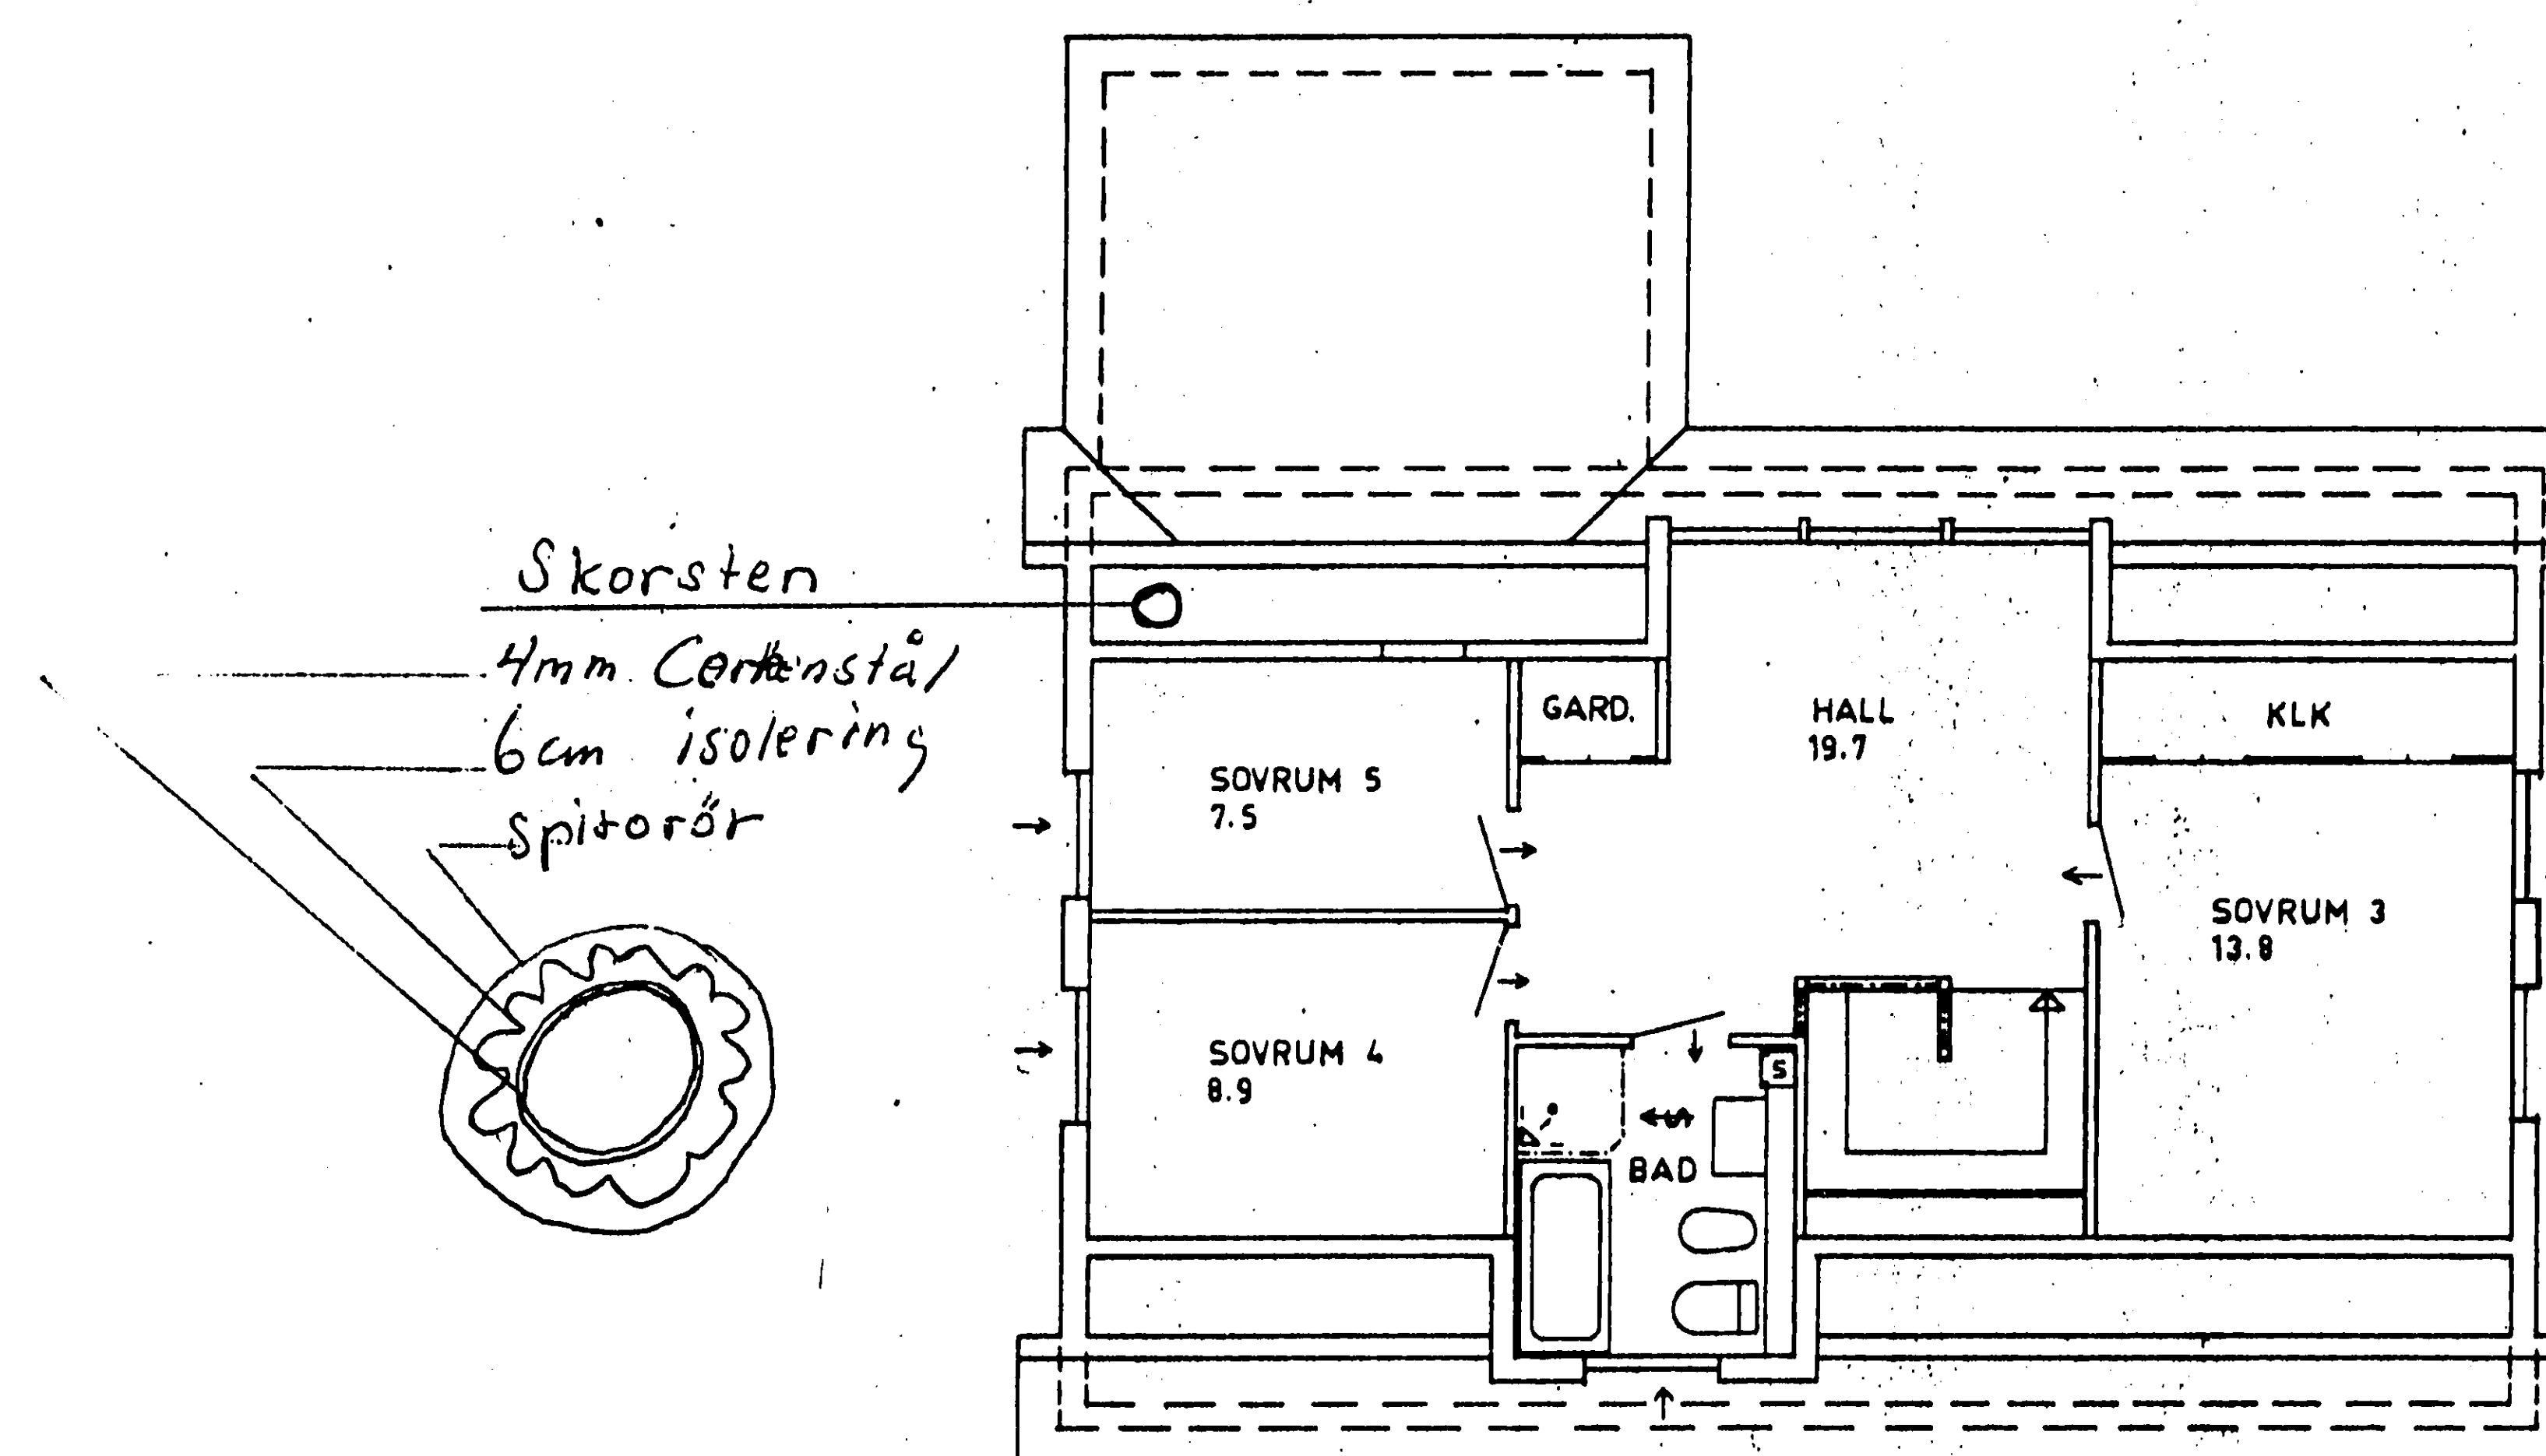

VINDSPLAN
INV. VTA 63.2 M²
VV 69.3 +
BIY 75.7 +

057098

Dnr 1980.479

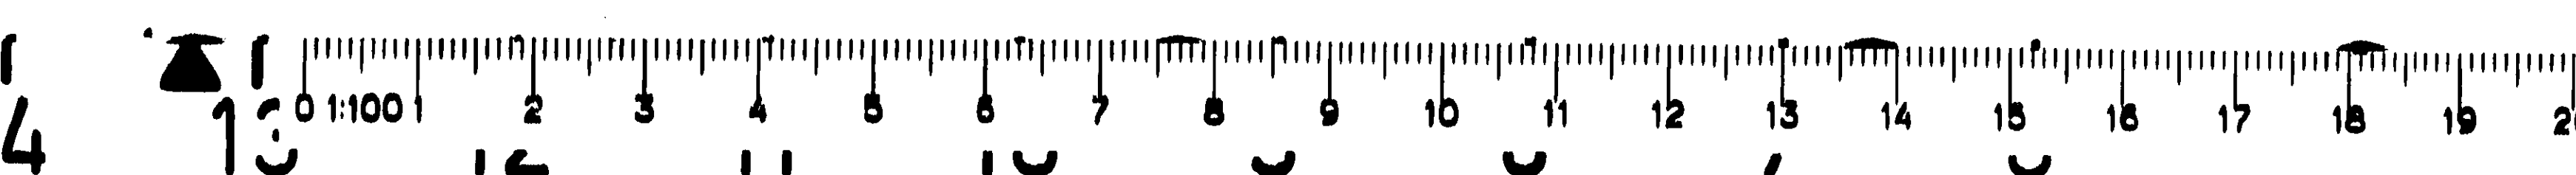

RULLE

148X

Stens- &
Mikrotjänst AB

6

7

8

9

10

11

12

13

14