


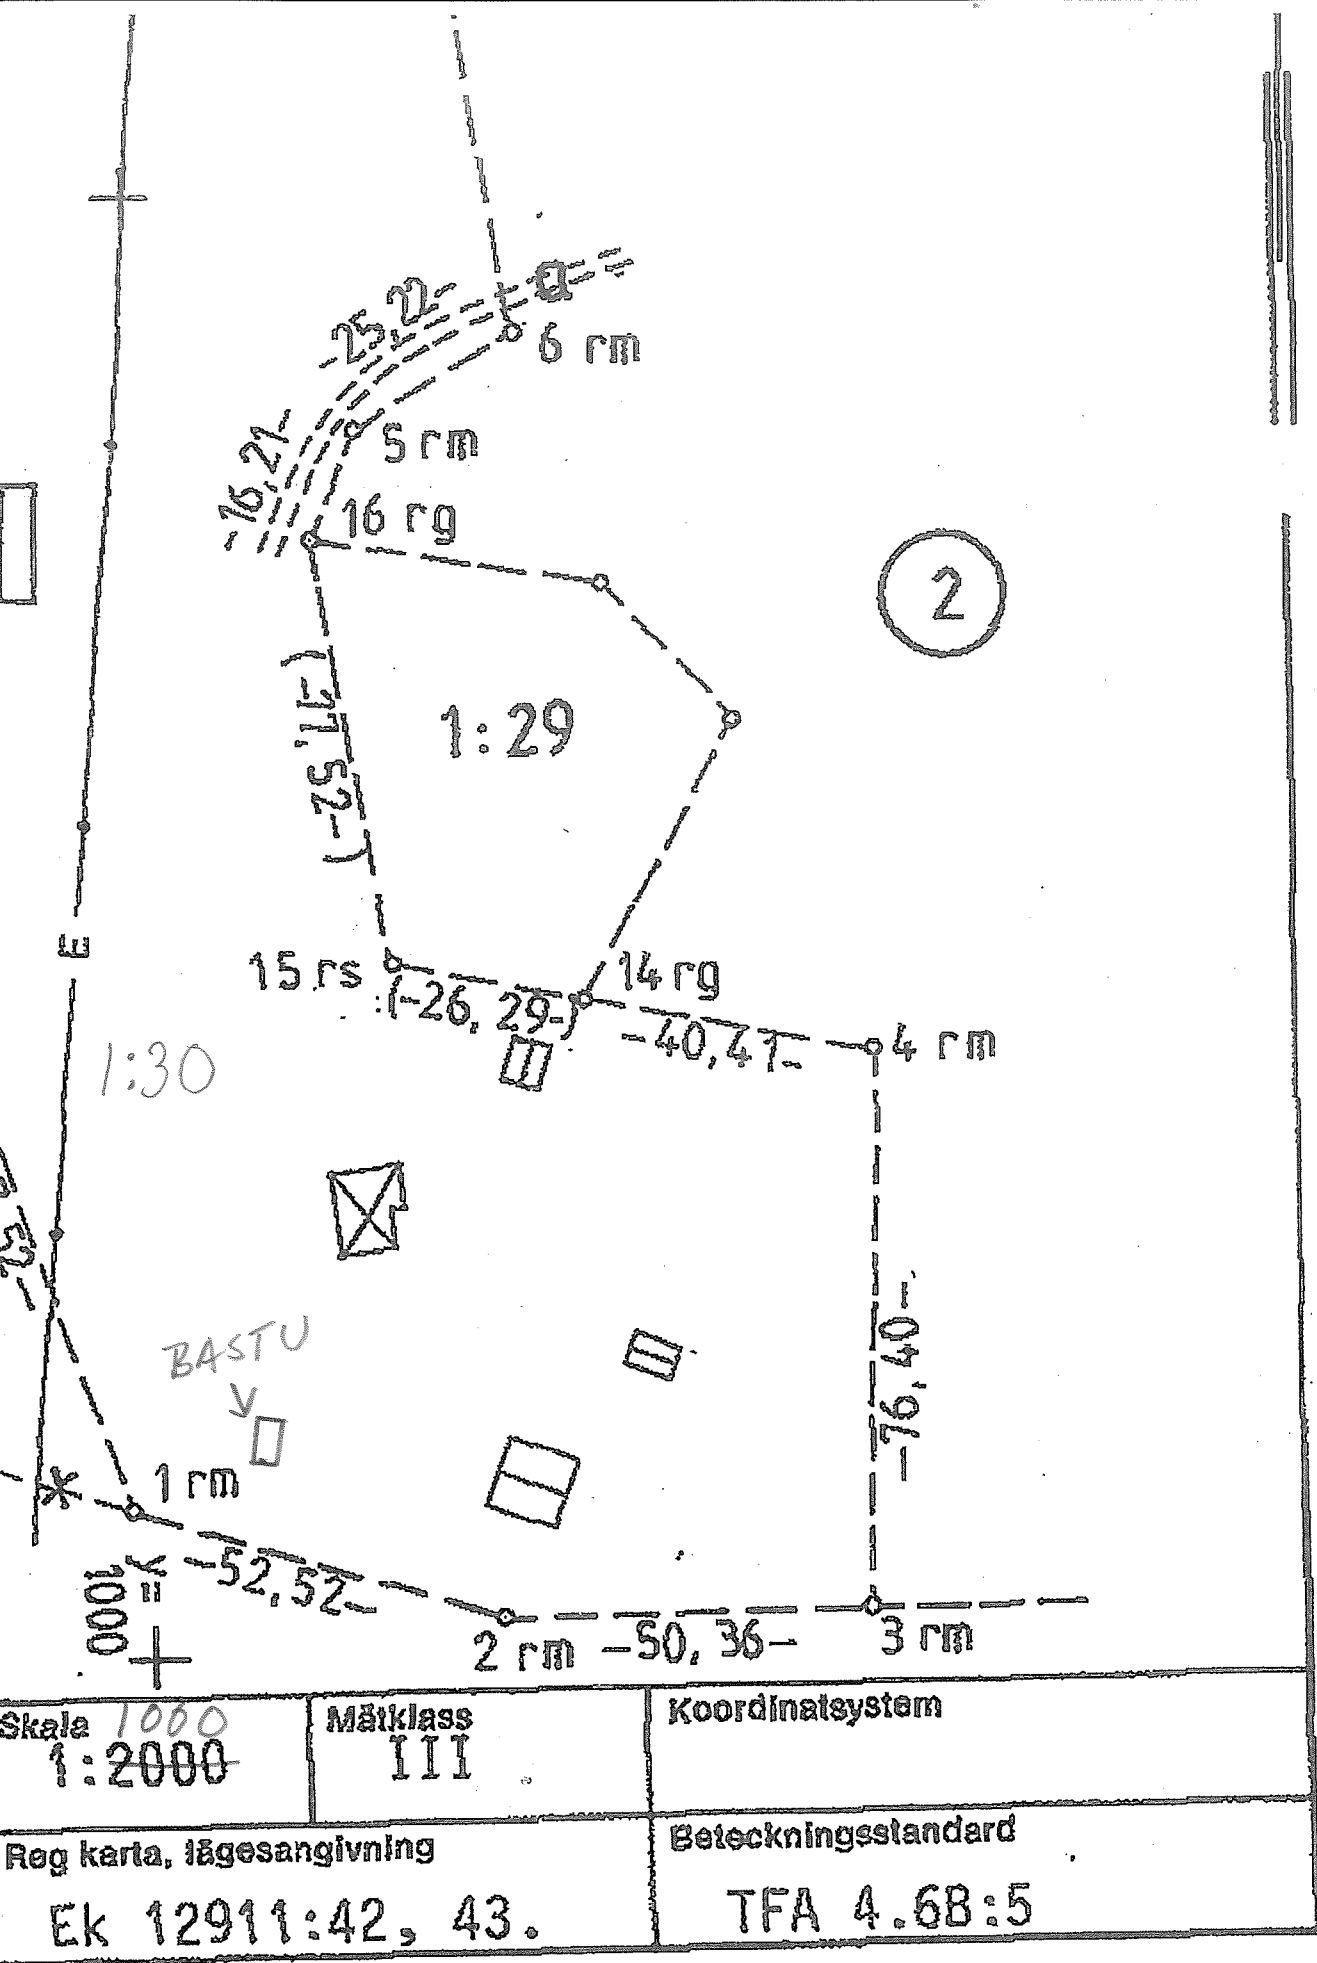

0188 - 89/264

Coll 149