


220432

S-PLAN	BERGSHAMRA 1:544.375.16 BERGSHAMRA 1:387	UTSTÄR 26-10-73
1:1000	LÄNNA SV	BK TS
MÄTT: 11,10 x 6,30		RIT AV TS
		B-LDV 780 728

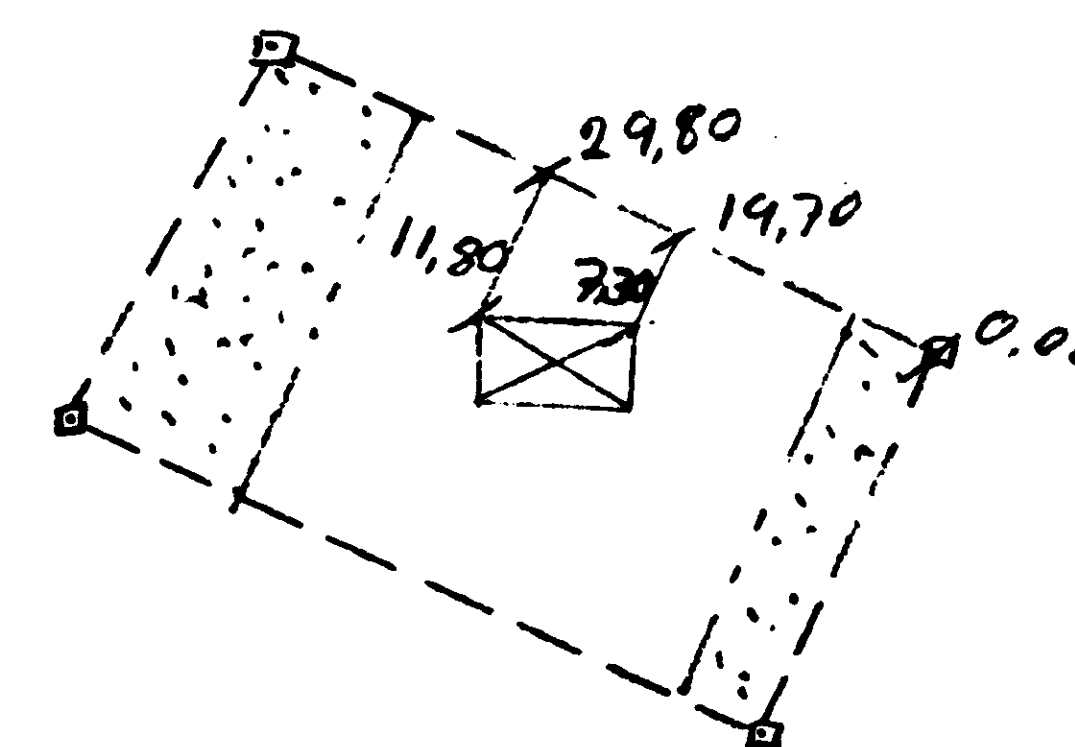

71250 - 113 M

ESSRUTE
17225