


Edeby 6:34 23-03-08

Ny tillbyggnad
2,9 x 2,0 m

Ny veranda
6,5 x 3,0 m

9,3 m

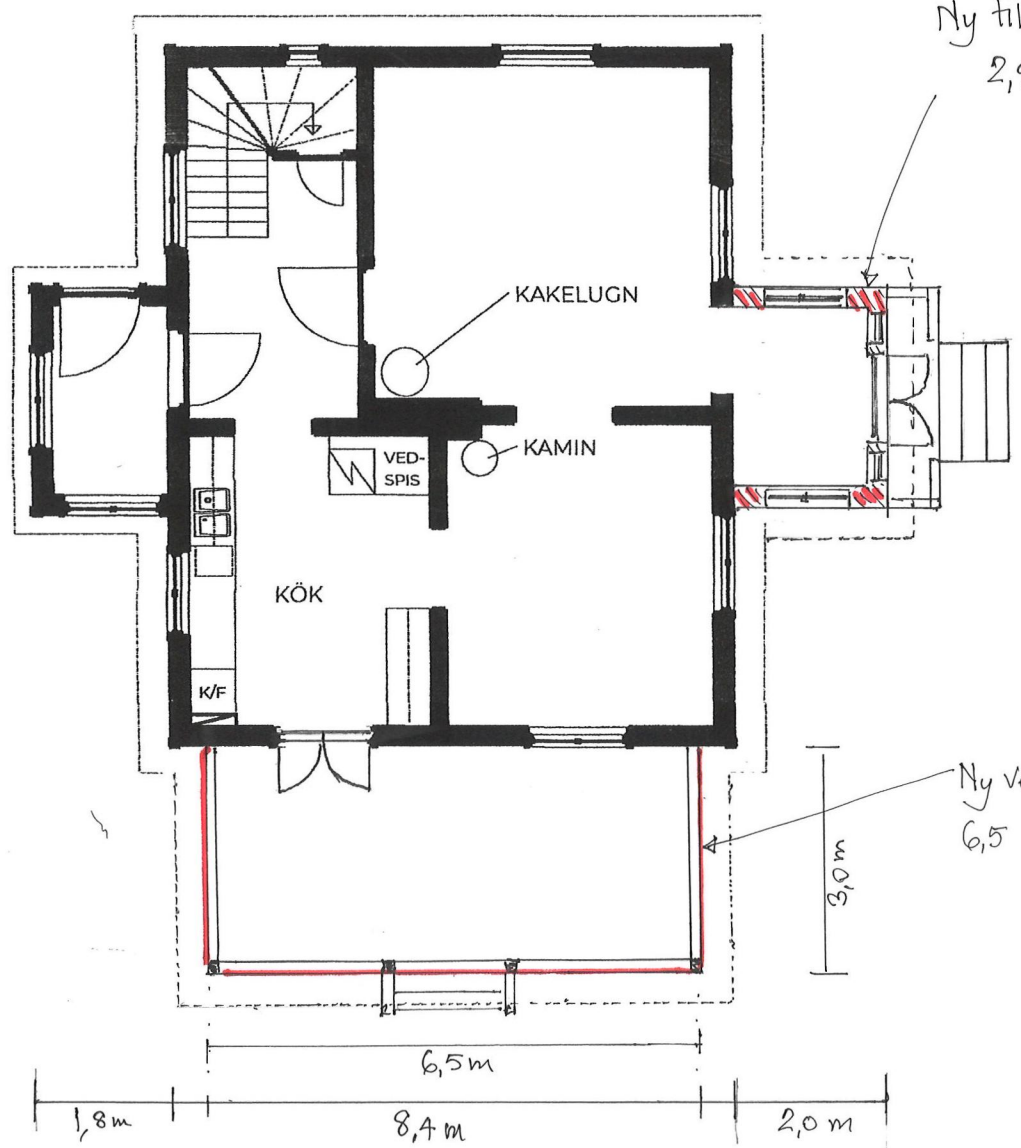

SKALA 1:100

