

Överlöpe 3:4 del av

Ⓟ 3:4

X=6638950

+

+


ÖVERLÖPE

3:4

X=6638900

+

+

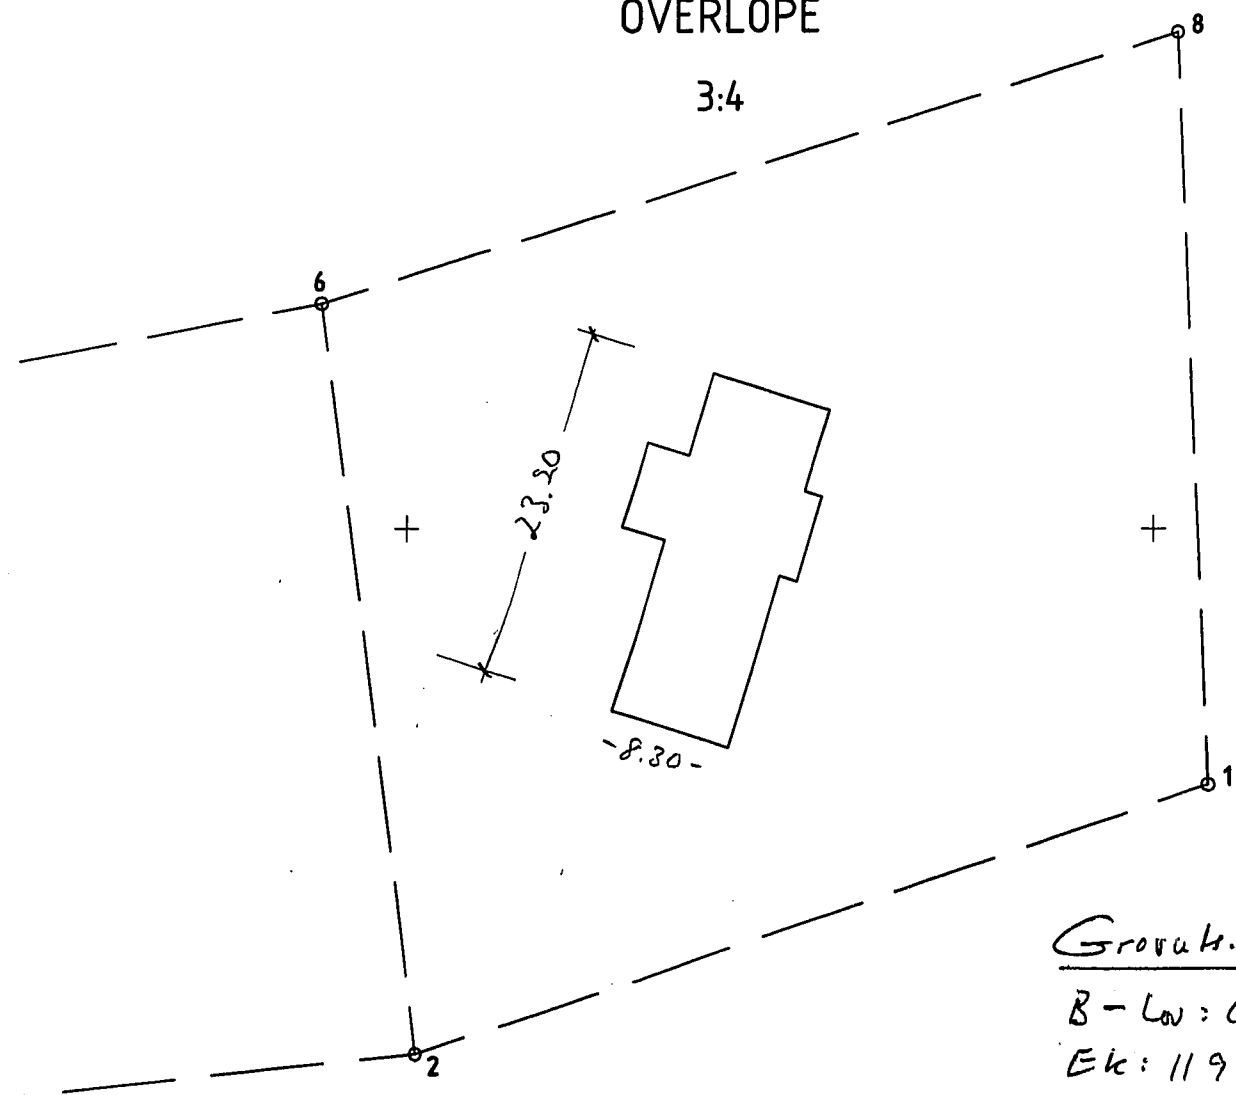

Grovsk. hus ent. skiss 070411

B-Lov: 070221

Ek: 11974

X=6638850

+ Y=1674500

+ Y=1674550

	Ⓧ	Ⓨ
HH*00000101	6638885.697	1674521.629
HH*00000102	6638907.812	1674528.258
HH*00000103	6638910.247	1674520.458
HH*00000104	6638888.083	1674513.709

Skala: 1:500

